


T.6S.R.1W.W.M.

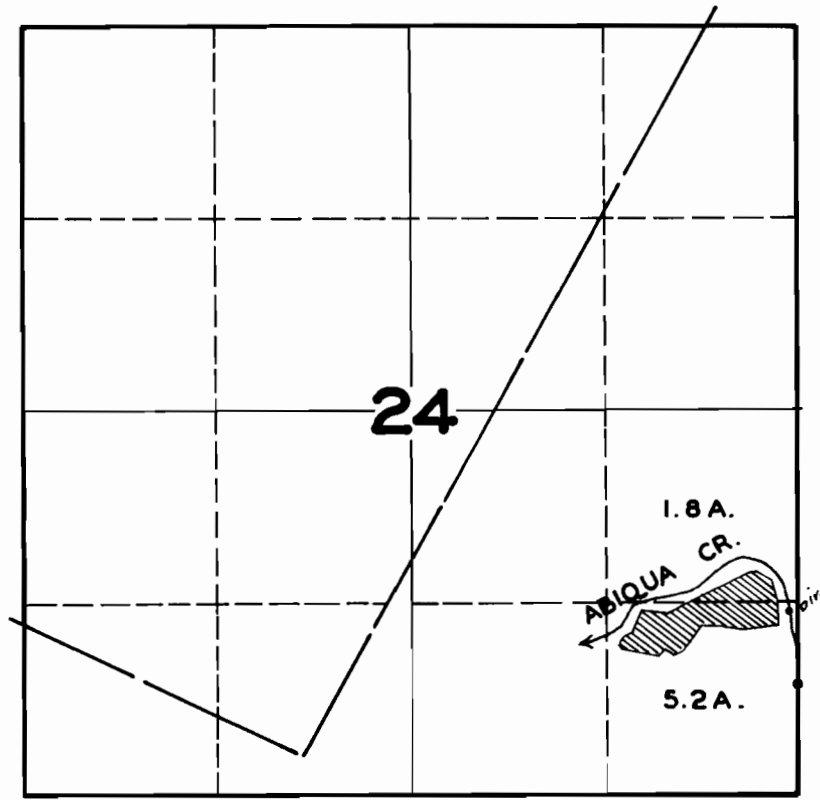

FINAL PROOF SURVEY UNDER

Application No. 21703 Permit No. 17094
IN NAME OF

JOHN P. WEISSENFELS

Surveyed AUG. 4 1947, by JAS. E. BUNNELL