


# T.3S.R.IW.W.M.

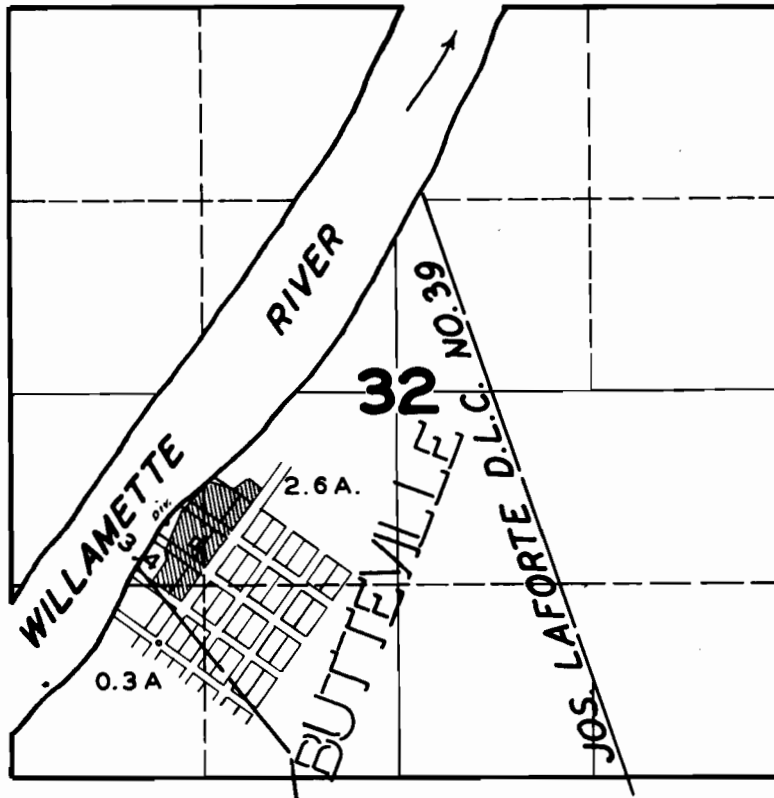

## FINAL PROOF SURVEY UNDER

Application No. **21725** ... Permit No. **17104** ...  
IN NAME OF

**B. BREITHAUP**

Surveyed **OCT. 28 1947**, by **JAS. E. BUNNELL**