


T.5S.R.1W.W.M.

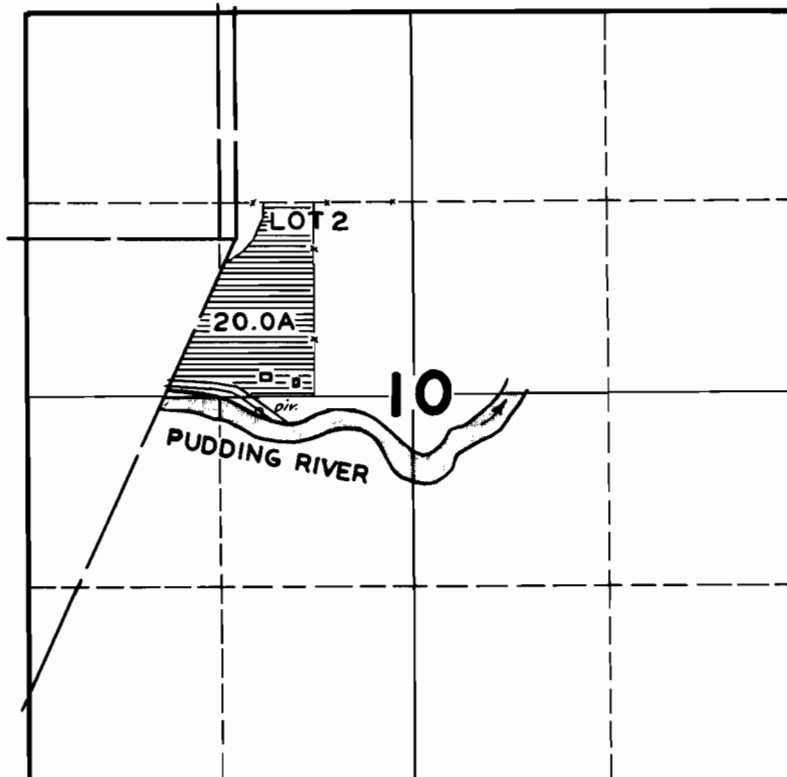

**FINAL PROOF SURVEY
UNDER**

Application No. 21751 Permit No. 17112

IN NAME OF

FRED D. SCHROEDER

Surveyed JUL. 29, 1947, by JAS. E. BUNNELL