


T.4S. R.5W., W.M.

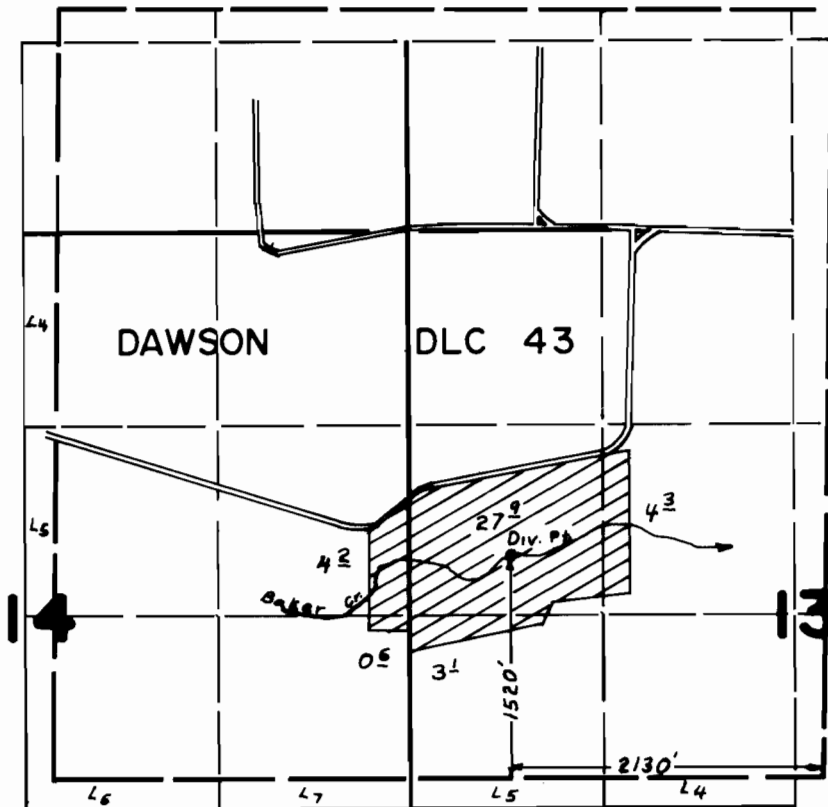

FINAL PROOF SURVEY UNDER

Application No. 21757..... Permit No. 17115.....
IN NAME OF

.....JOHN MAGEE.....

Surveyed APR. 3. 1947., by J.E. BUNNELL.....