


# T.6S.R.1W.W.M.

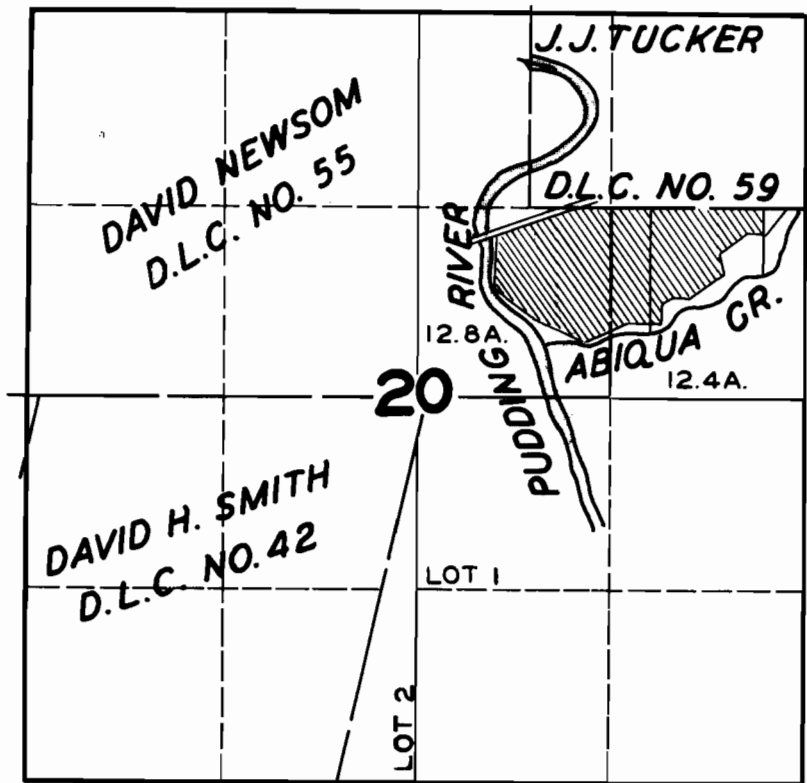

## FINAL PROOF SURVEY UNDER

Application No. 21761..... Permit No. 17119.....  
IN NAME OF

FELIX SCHULTZ

Surveyed SEP. 2 1948, by JAS. E. BUNNELL