


T.3S.R.2W.W.M.

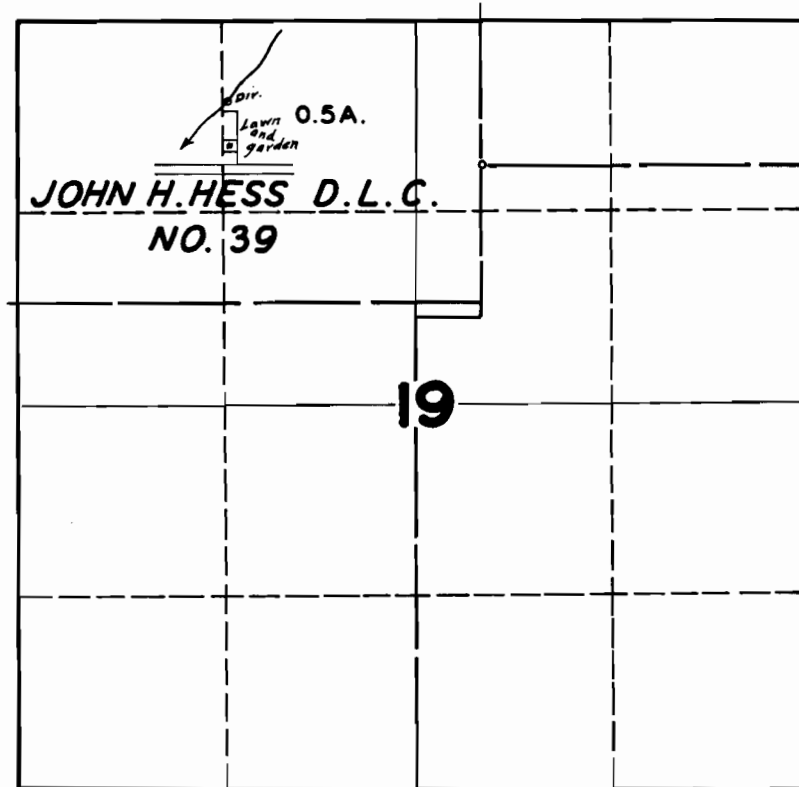

FINAL PROOF SURVEY

UNDER

Application No. ~~21844~~ Permit No. ~~17182~~

IN NAME OF

~~ROY C. BAKER~~

Surveyed APR. 4... 1947., by JAS. E. BUNNELL