


T.8S.R.6W.W.M.

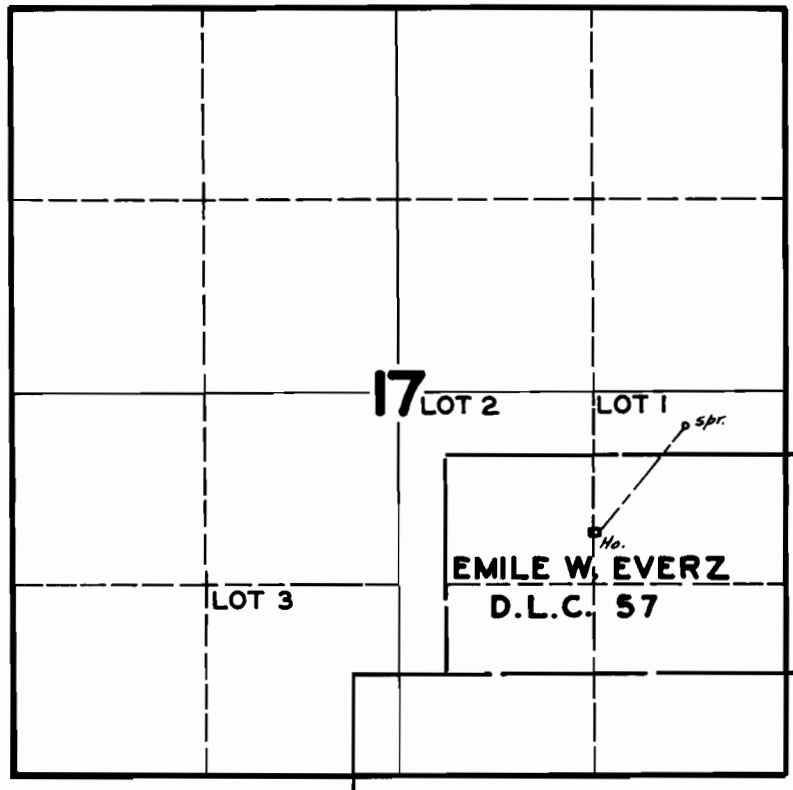

FINAL PROOF SURVEY
UNDER

Application No. **21845** Permit No. **17183**
IN NAME OF

KARL WAGNER

Surveyed **SEP. 13** 1947, by **JAS. E. BUNNELL**