


# T.3S.R.3W.W.M.

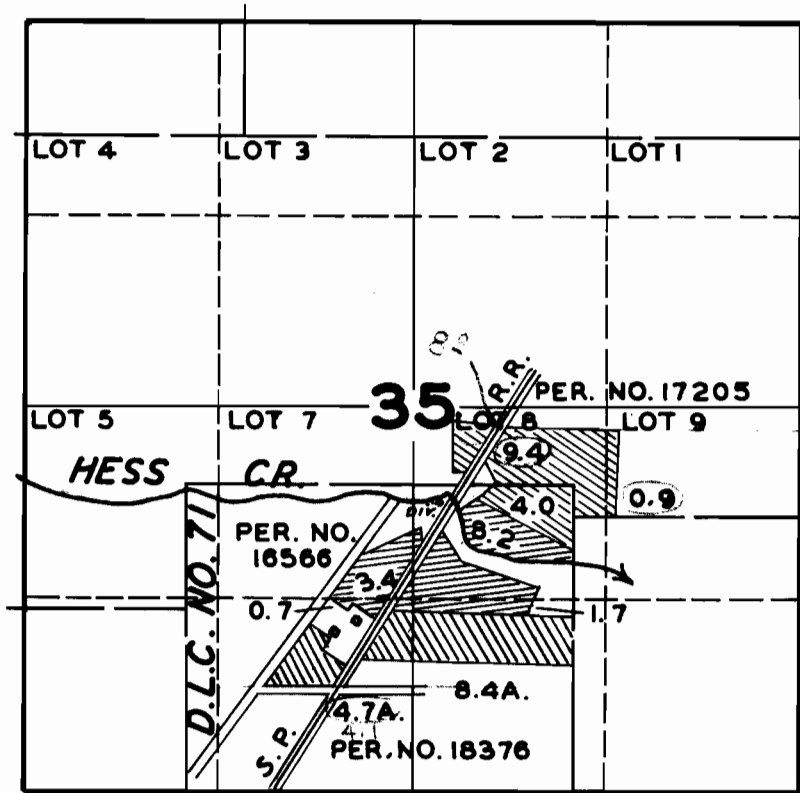

## FINAL PROOF SURVEY

UNDER

21137 - 21882 17205-16566

Application No. ~~23293~~ Permit No. ~~18376~~

IN NAME OF

FRANCIS A. BUCKLEY

Surveyed APR. 11. 1949, by JAS. E. BUNNELL