


T.16S.R.2W.W.M.

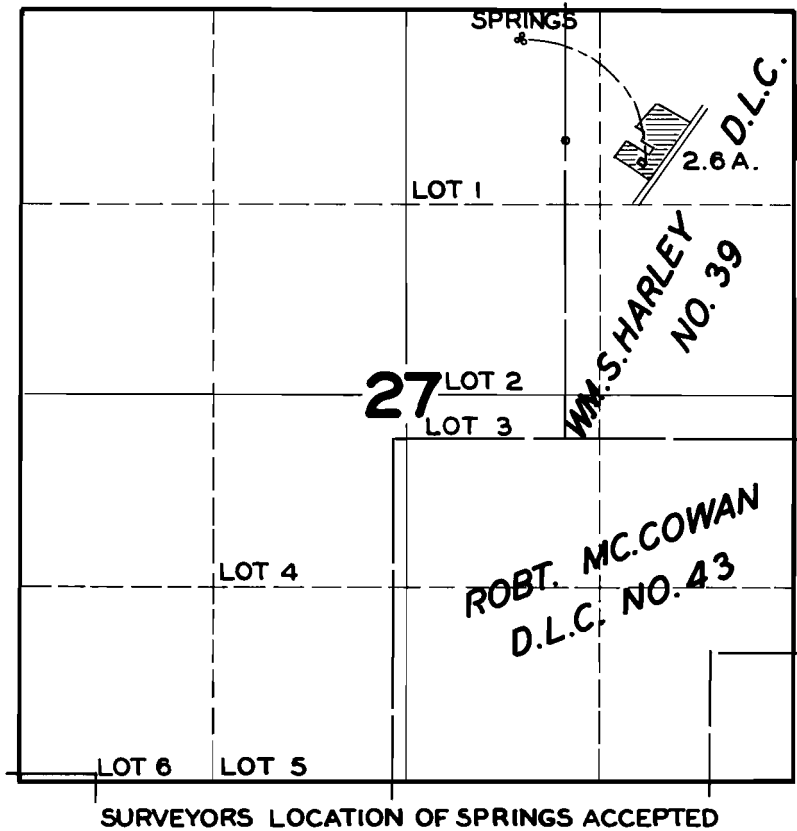

FINAL PROOF SURVEY
UNDER

Application No. **21904** Permit No. **17244**
IN NAME OF

HARRY T. ORR

Surveyed **JUNE 24 1948**, by **JAS. E. BUNNELL**