


T.13&14S.R.2E.W.M.

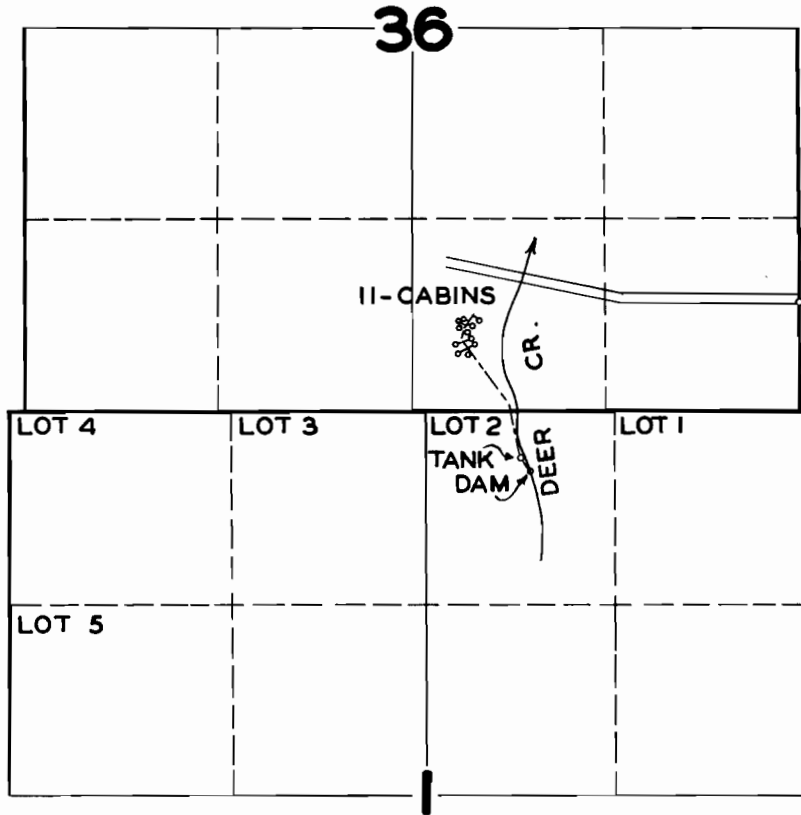

FINAL PROOF SURVEY UNDER

Application No. 22003 Permit No. 17300

IN NAME OF

WILLAMETTE NATIONAL LUMBER CO.

Surveyed SEP. 2, 1947, by JAS. E. BUNNELL