


T.14S.R.2W.W.M.

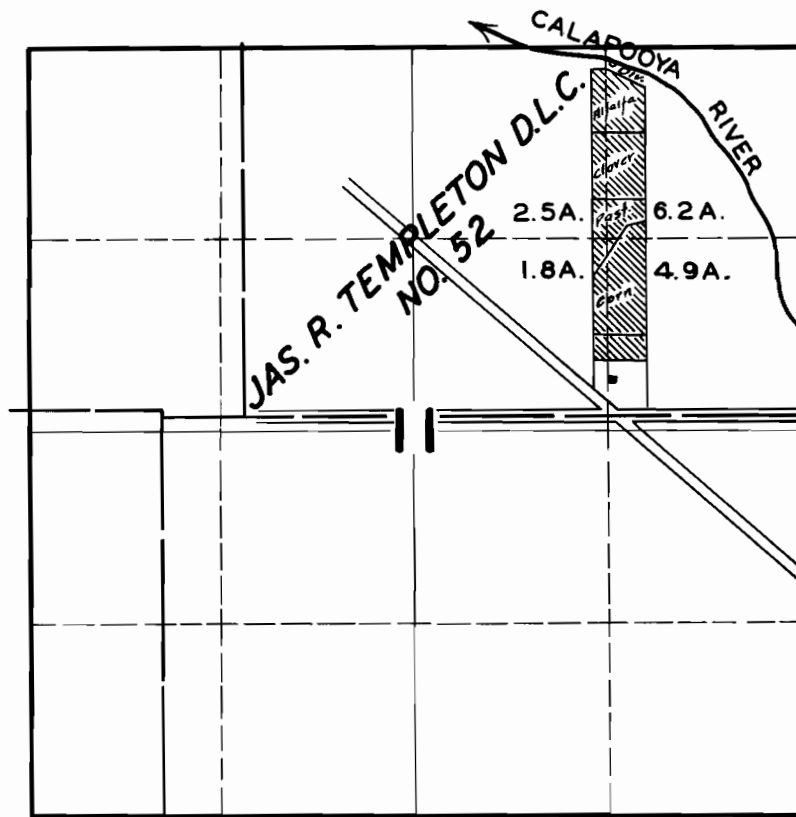

FINAL PROOF SURVEY UNDER

Application No. 22020 Permit No. 17303

IN NAME OF

HAROLD VAN EPPS

Surveyed AUG. 27 1947, by JAS. E. BUNNELL