


T.5S.R.1W.W.M.

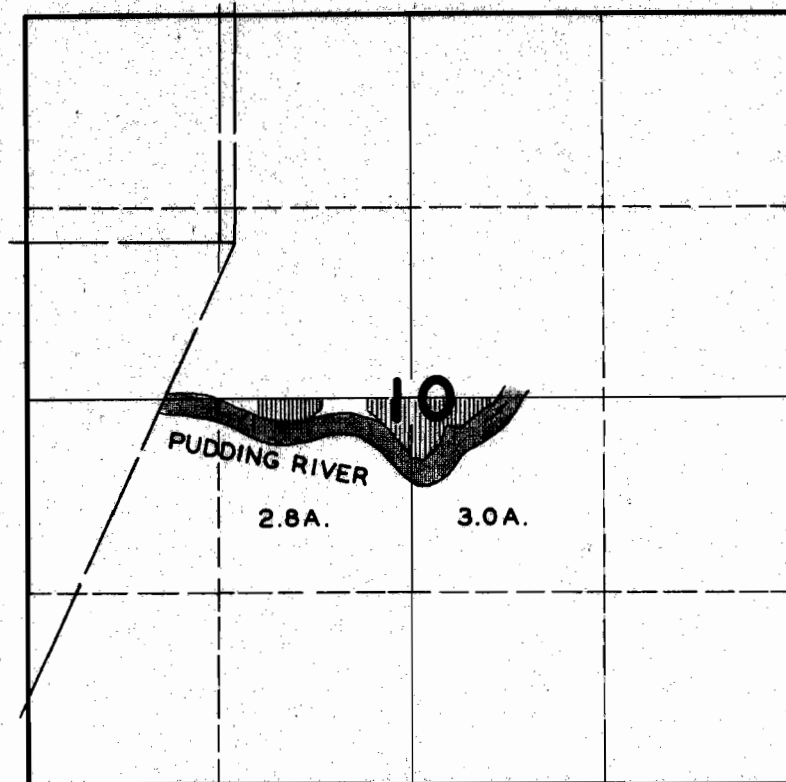

**FINAL PROOF SURVEY
UNDER**

Application No. 22056 Permit No. 17363

IN NAME OF

KENNETH YODER

Surveyed OCT. 1, 1947, by JAS. E. BUNNELL