


T.5S.R.3W.W.M.

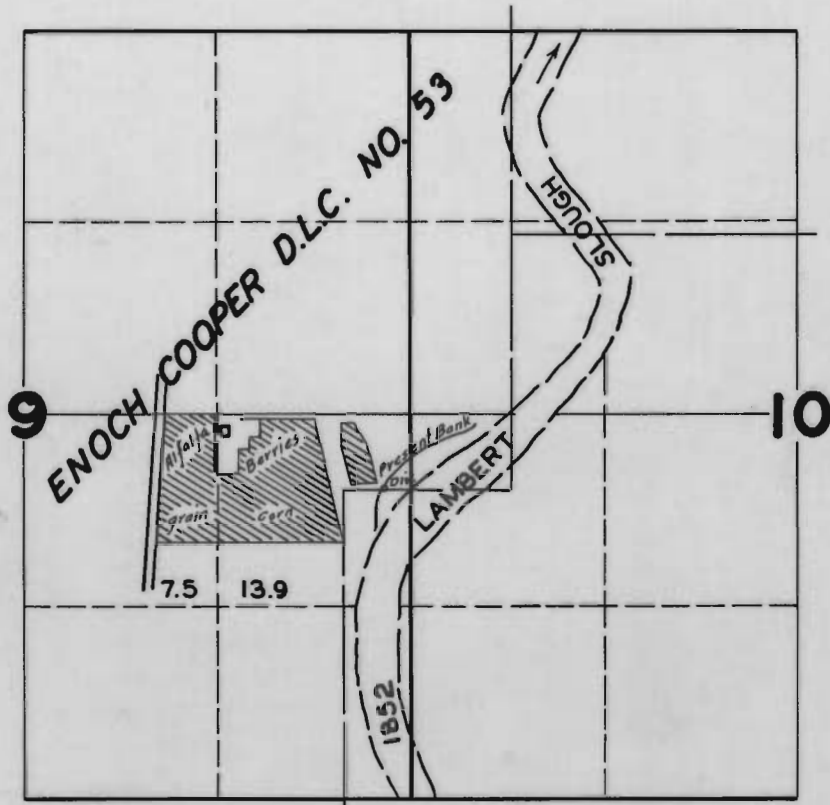

FINAL PROOF SURVEY

UNDER

Application No. **22118** Permit No. **17424**

IN NAME OF

GEORGE W. STRAWN

Surveyed **JUN. 26, 1947**, by **JAS. E. BUNNELL**

*This map does not check out with Subsequent work
Appears to be a error from platt book layout*