


T.5S.R.6W.W.M.

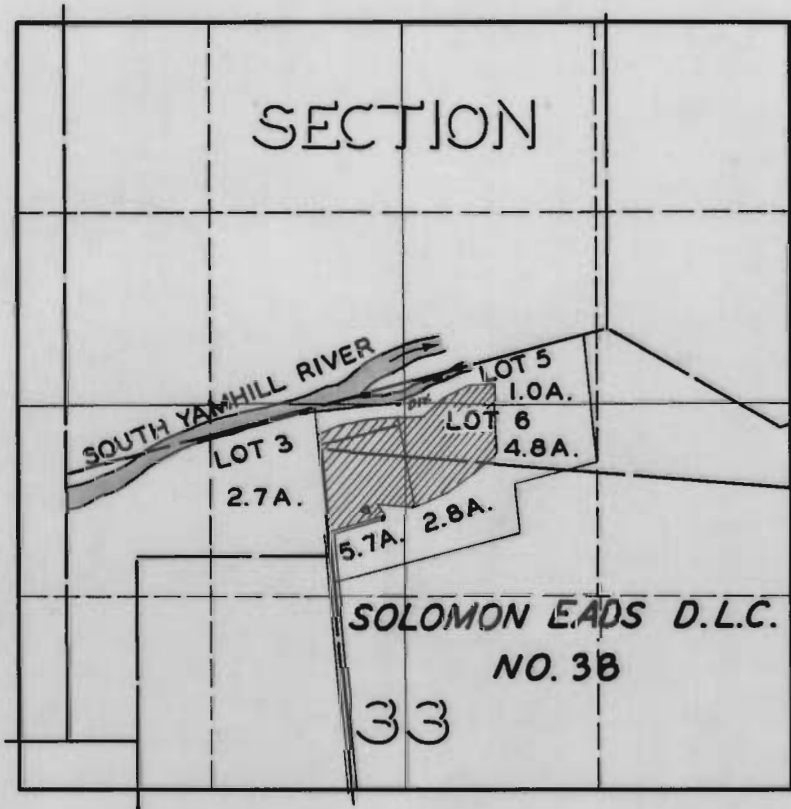

FINAL PROOF SURVEY
UNDER

Application No. **22135** Permit No. **17433**

IN NAME OF

O.C. BEALS

Surveyed **JULY 1, 1947**, by **JAS. E. BUNNELL**