


T.5S.R.1W.W.M.

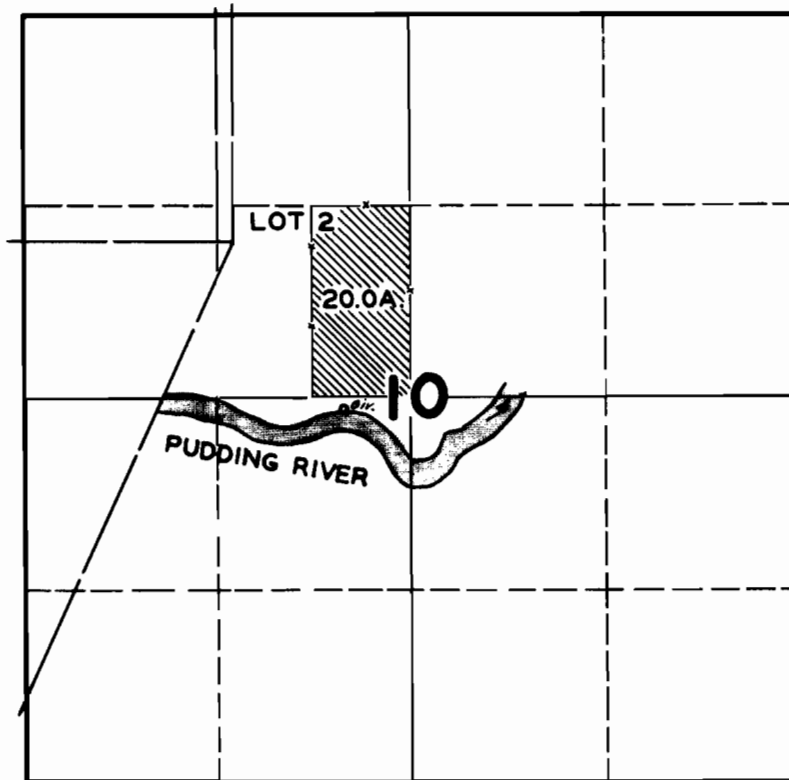

**FINAL PROOF SURVEY
UNDER**

Application No. 22194 Permit No. 17477

IN NAME OF

WE, HERBERT L. & ROBERT L. KOENIG

Surveyed APR. 16, 1947, by JAS. E. BUNNELL