


T.4S.R.IE.W.M.

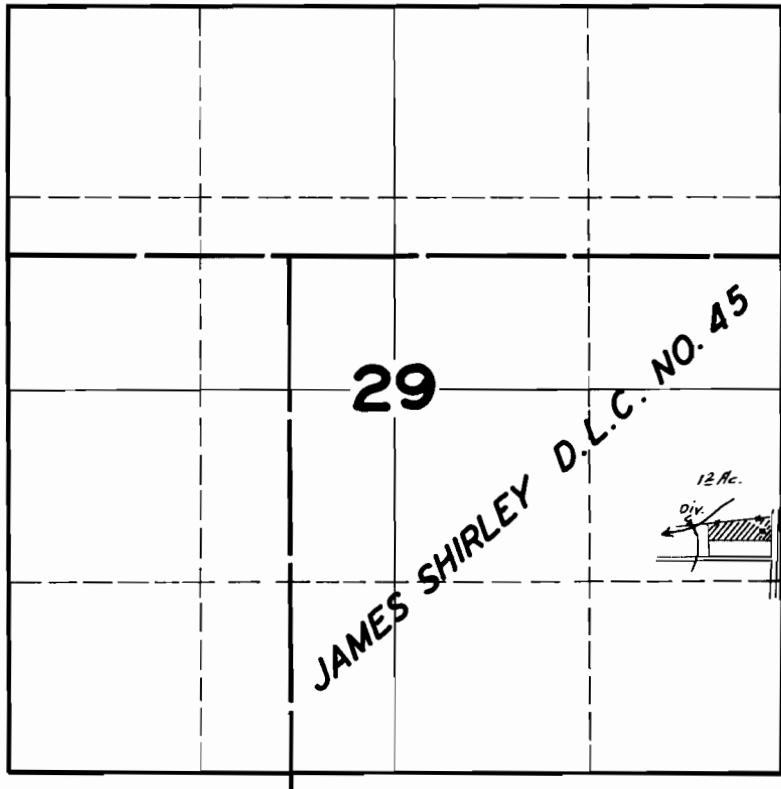

FINAL PROOF SURVEY UNDER

Application No. 22195 Permit No. 17478

IN NAME OF

EARL M. ADAMS

Surveyed OCT. 6 1947, by JAS. E. BUNNELL