


T. 9S. R. 3E. W. M.

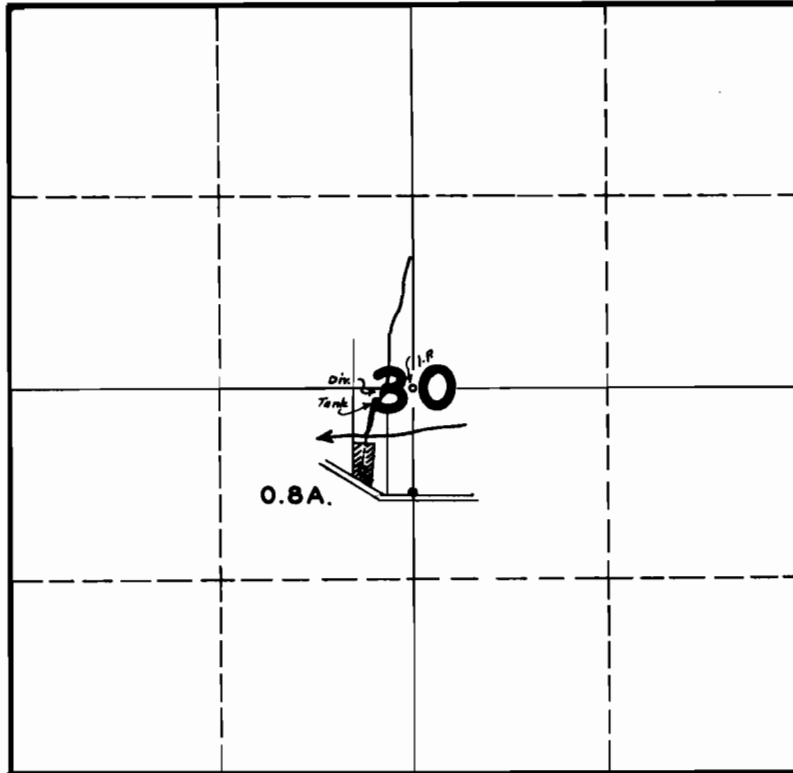

FINAL PROOF SURVEY UNDER

Application No. 22199 Permit No. 17481.....
IN NAME OF

CLARENCE ESTENSON

Surveyed MAY 26 1947, by JAS. E. BUNNELL