


**T.9S.R.2W.W.M.**

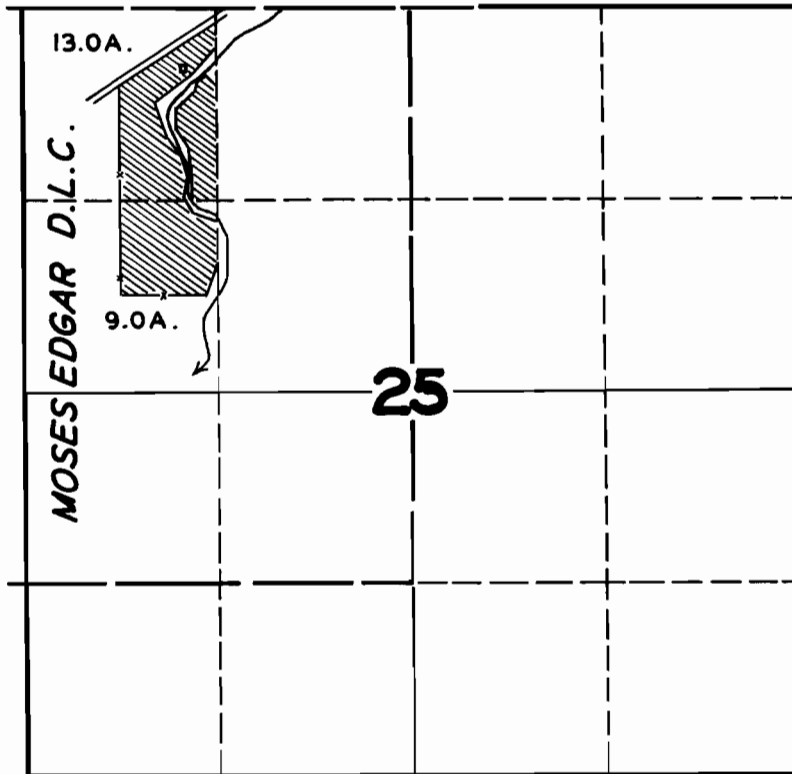

**FINAL PROOF SURVEY**  
UNDER

Application No. **22284** Permit No. **17573**  
IN NAME OF

**JOHN E. SCOFIELD**

Surveyed **SEP. 29 1947**, by **JAS. E. BUNNELL**