


T.IIS.R.7W.W.M.

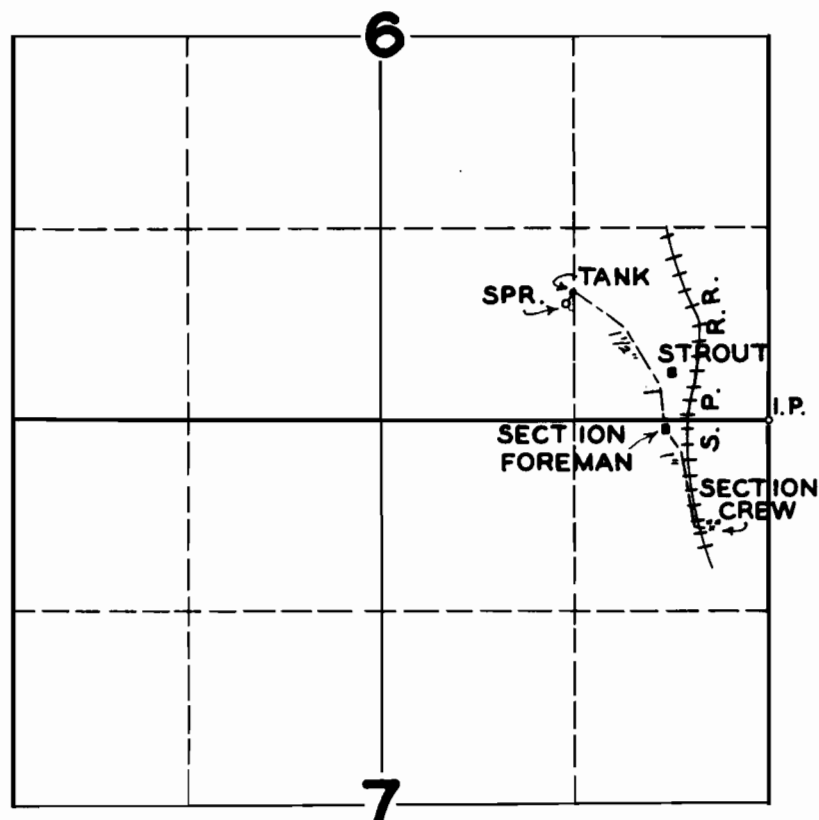

FINAL PROOF SURVEY

UNDER

Application No. **20630** Permit No. **17874**

IN NAME OF

SOUTHERN PACIFIC COMPANY

Surveyed **JULY 8** 1948, by **JAS. E. BUNNELL**