


T.10S.R.6W.W.M.

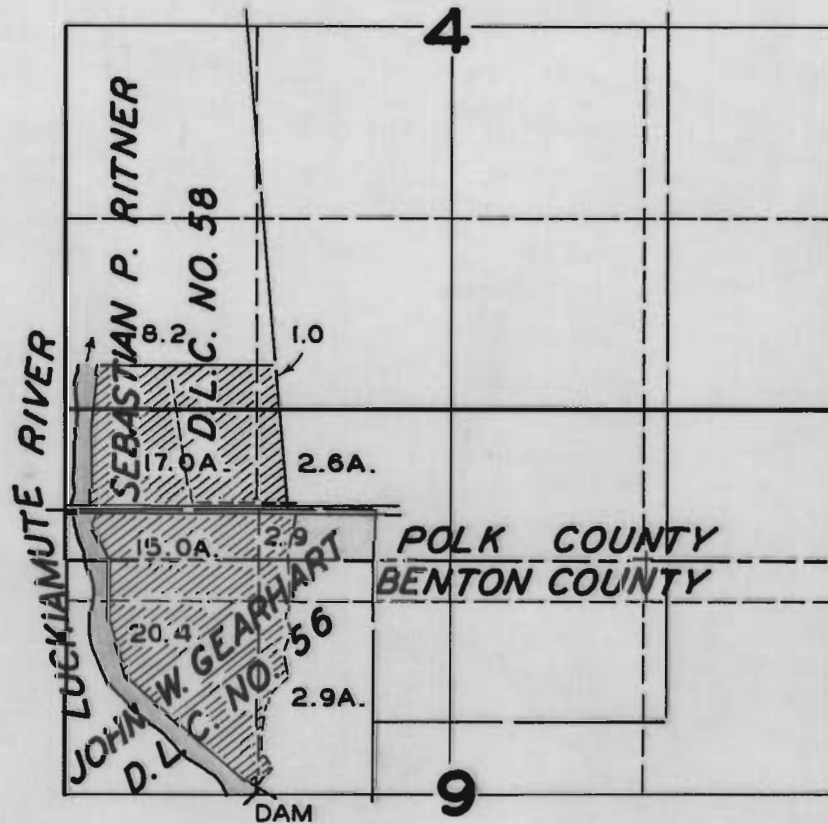

FINAL PROOF SURVEY

UNDER

Application No. 14755 Permit No. 10804

IN NAME OF

C. L. BUMP

Surveyed APR. 8, 1949, by JAS. E. BUNNELL