


T.3S.R.1W.W.M.

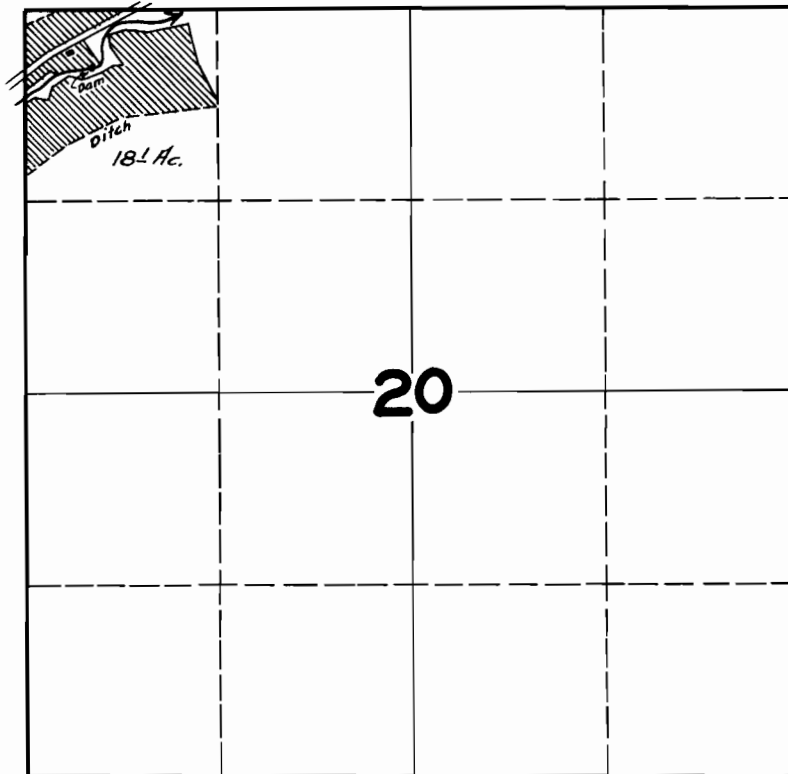

FINAL PROOF SURVEY
UNDER

Application No. 17614 Permit No. 13303

IN NAME OF

BENJAMIN A. MADDOX

Surveyed JUNE 9 1947, by JAS. E. BUNNELL