


T.19S.R.5W.W.M.

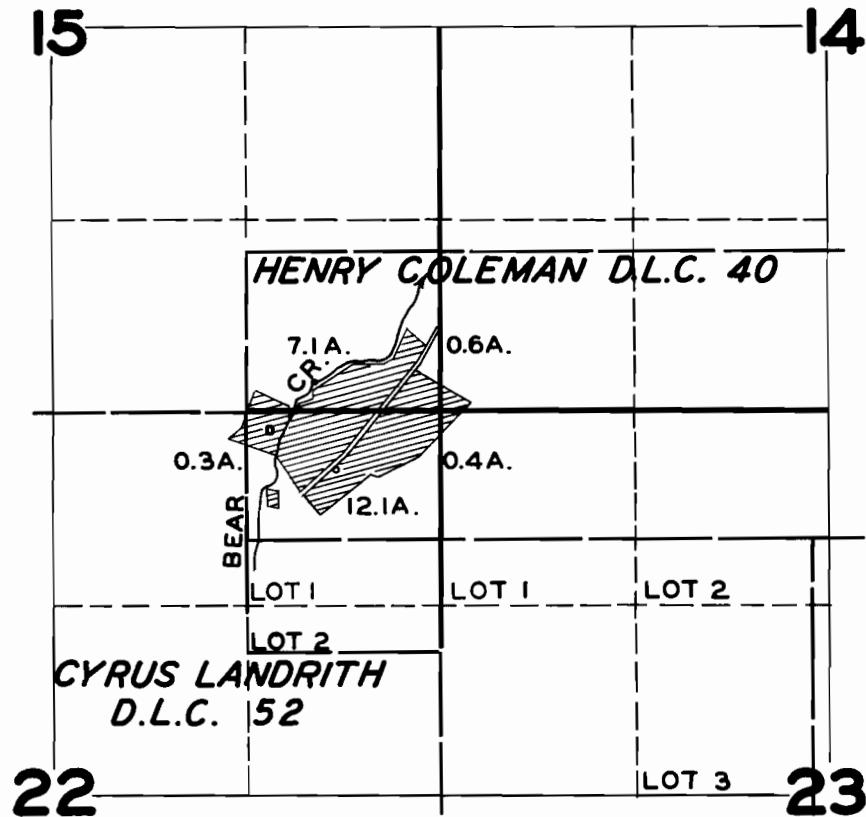

**FINAL PROOF SURVEY
UNDER**

Application No. 17669 Permit No. 13408

IN NAME OF

ALBERT CLINE

Surveyed AUG. 7, 1947, by JAS. E. BUNNELL