


T.4S.R.4W.W.M.

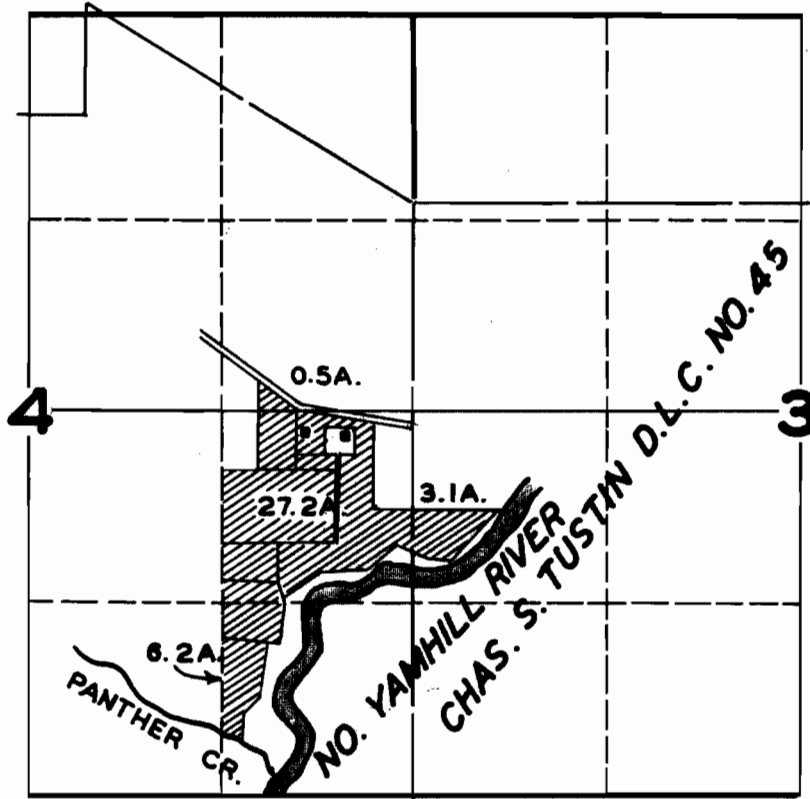

FINAL PROOF SURVEY

UNDER

17598

13314

Application No. 18231... Permit No. 13892...

IN NAME OF

WILLIAM H. GASS

Surveyed AUG. 18, 1948, by JAS. E. BUNNELL