


T.1&2S. R.2W.W.M.

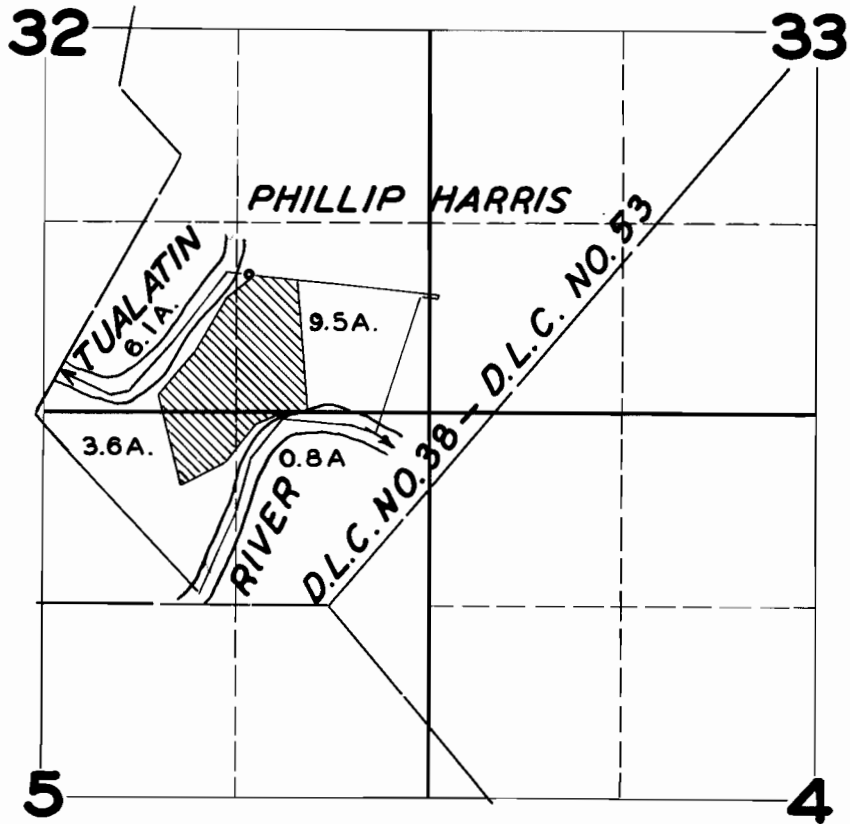

FINAL PROOF SURVEY

UNDER

Application No. **18235** Permit No. **13896**

IN NAME OF

DENNIS L. DAVIS

Surveyed **MAY 20, 1948**, by **JAS. E. BUNNELL**