


T. 7S. R. 4W. W.M.

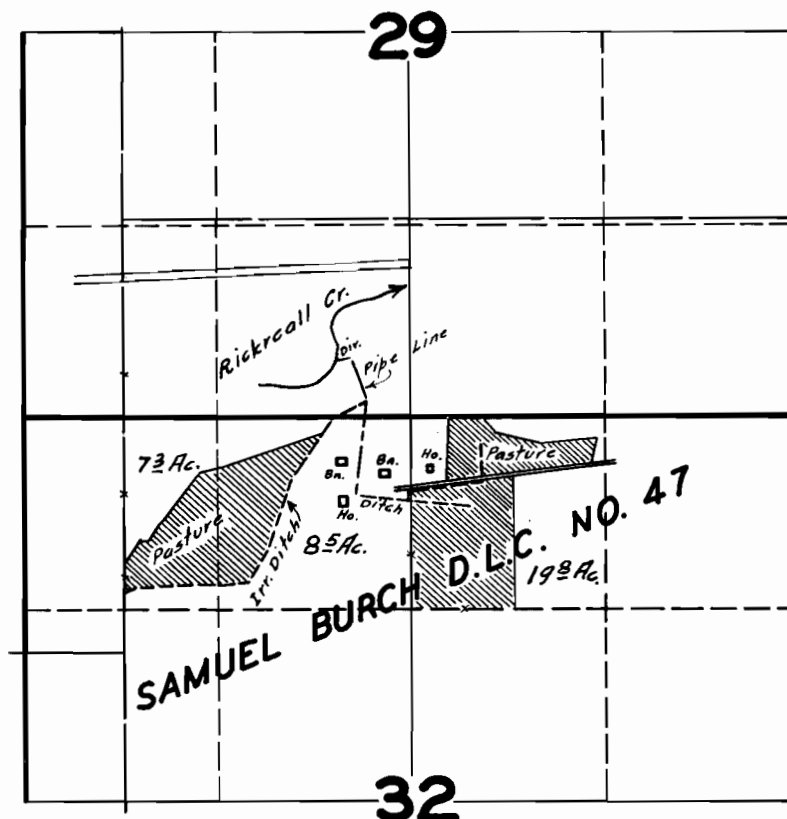

FINAL PROOF SURVEY UNDER

Application No. **18259** ... Permit No. **13915** ...
IN NAME OF

C. BARENDRECHT

Surveyed **MAR. 14, 1947**, by **JAS. E. BUNNELL**