


T.5S.R.1W.W.M.

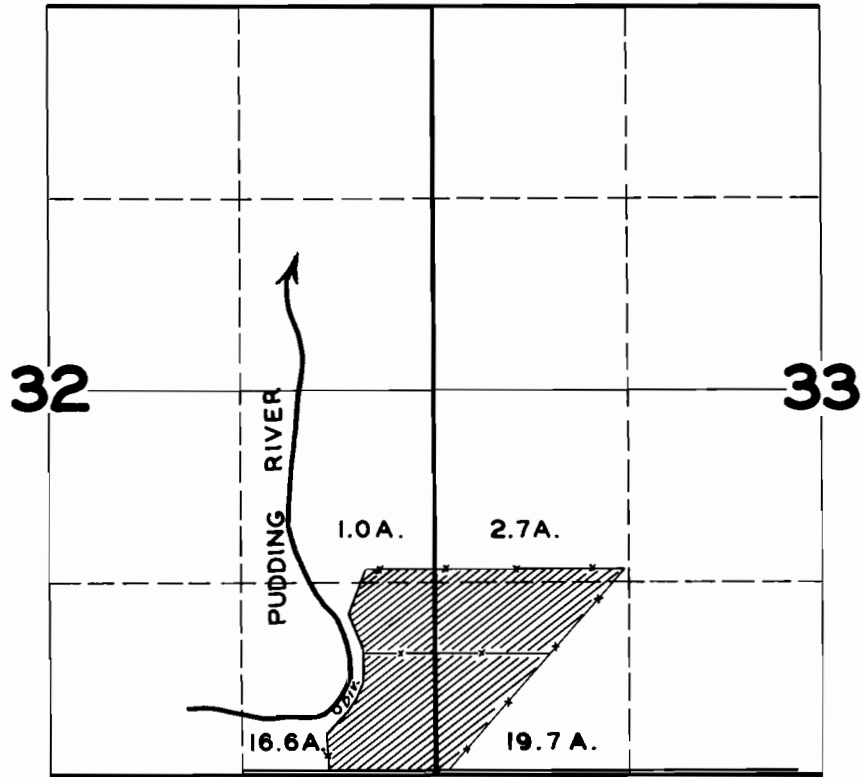

FINAL PROOF SURVEY UNDER

Application No. 18289 Permit No. 13936

IN NAME OF

HUGO HEMSHORN

Surveyed JUL. 29 1947, by JAS. E. BUNNELL