


T. I. S. R. 2 W. W. M.

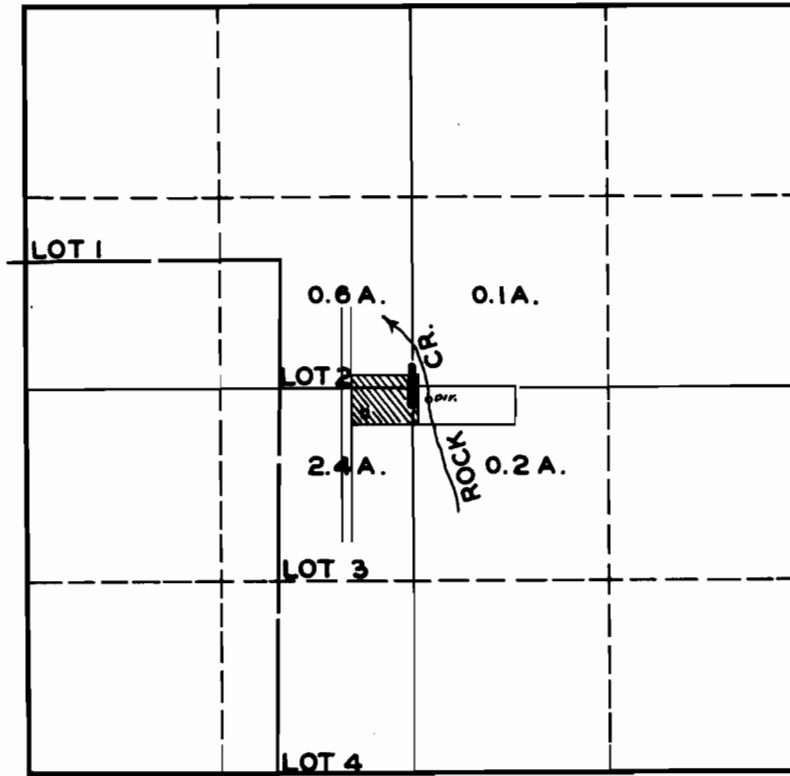

FINAL PROOF SURVEY UNDER

Application No. 18104 Permit No. 13995
IN NAME OF

PIETRO & HELEN BELLUSCHI

Surveyed JULY 31, 1947, by JAS. E. BUNNELL