


T.14S.R.8W.W.M.

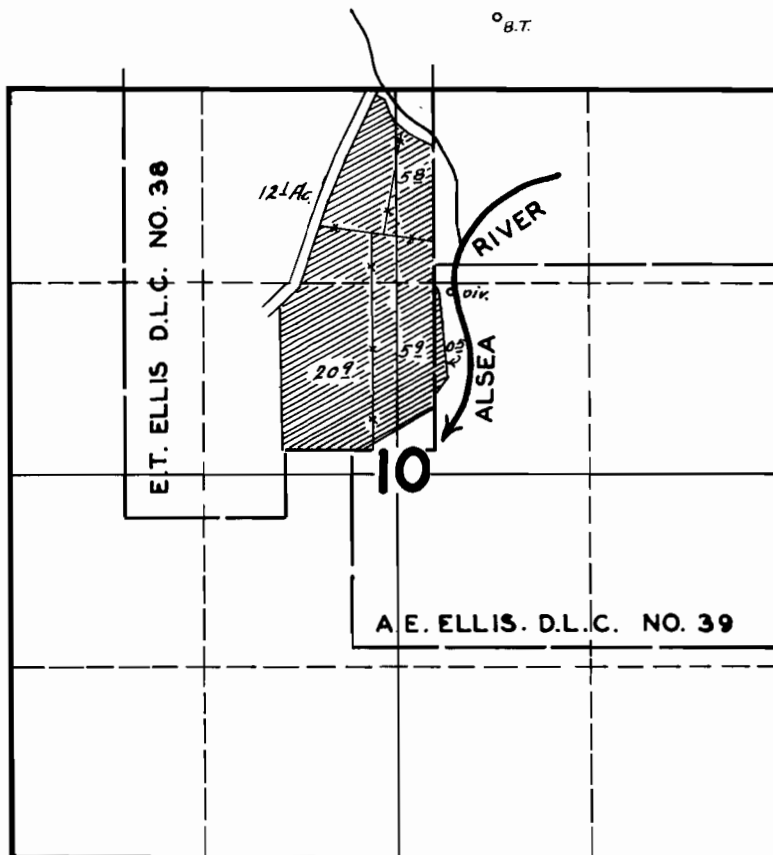

FINAL PROOF SURVEY UNDER

Application No. 18511 Permit No. 14164

IN NAME OF

ANDREW ANDERSON

Surveyed JUL. 16. 1947. by JAS. E. BUNNELL