


T.5&6S. R.8W.W.M.

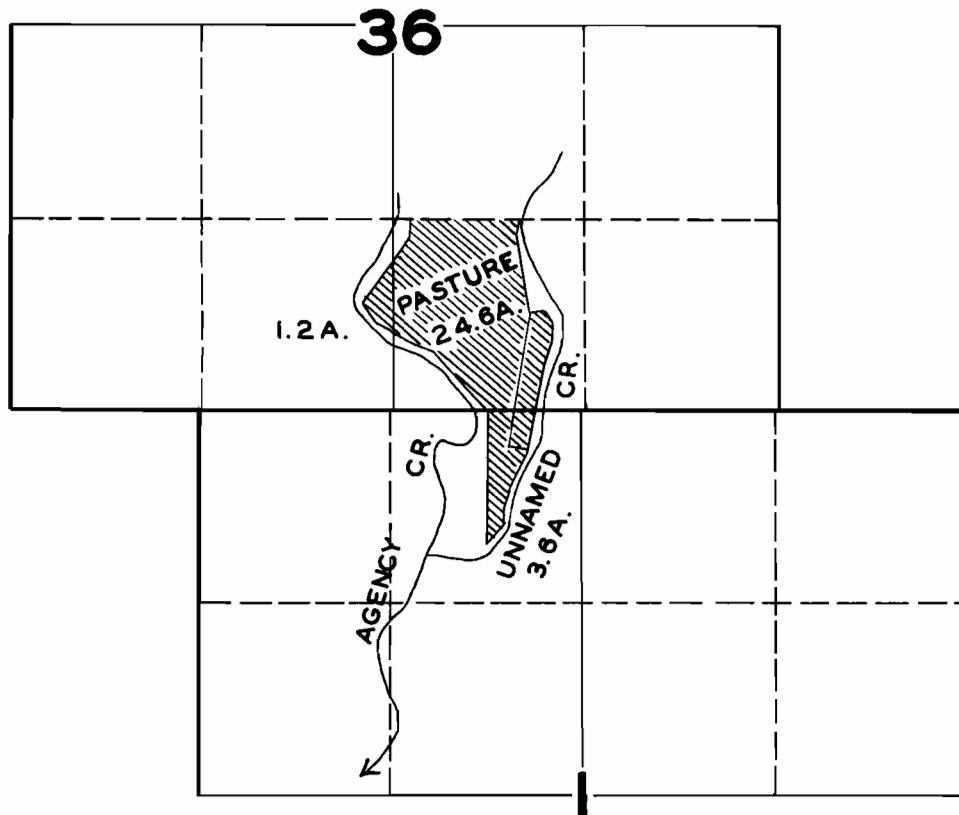

FINAL PROOF SURVEY
UNDER

Application No. **18532**... Permit No. **14171**.....
IN NAME OF

HAROLD S. FAIRBROTHER

Surveyed **APR. 7, 1949**, by **JAS. E. BUNNELL**