


# T. 5S. R. 3E. W. M.

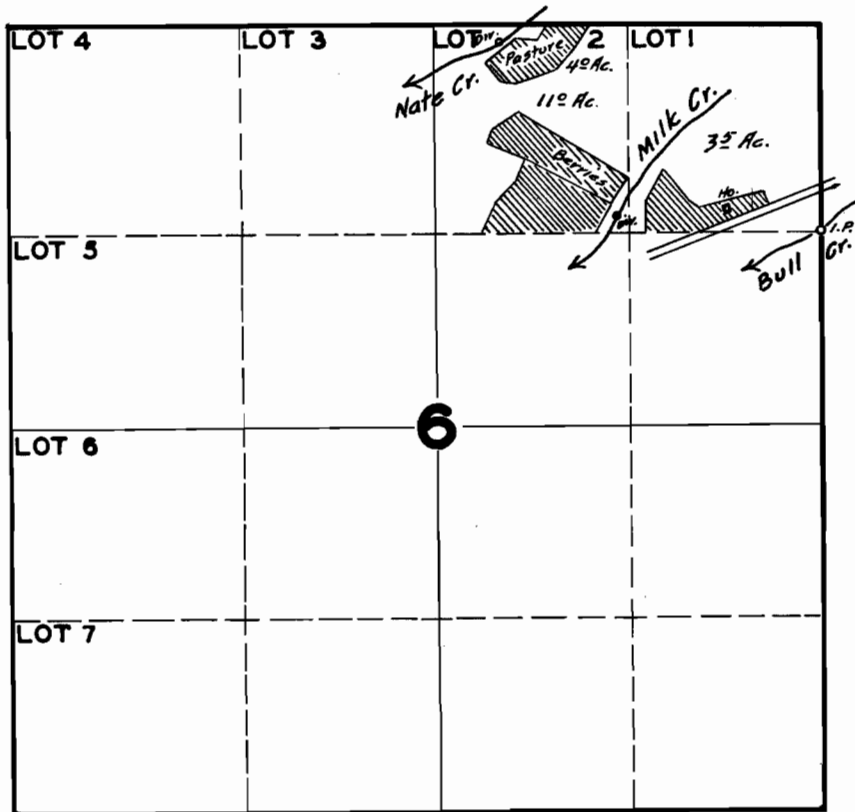

## FINAL PROOF SURVEY UNDER

Application No. 18843 Permit No. 14478

IN NAME OF

C. R. MORRIS & LETHA MORRIS

Surveyed JUN. 17, 1947, by JAS. E. BUNNELL