


T.2S.R.2E.W.M.

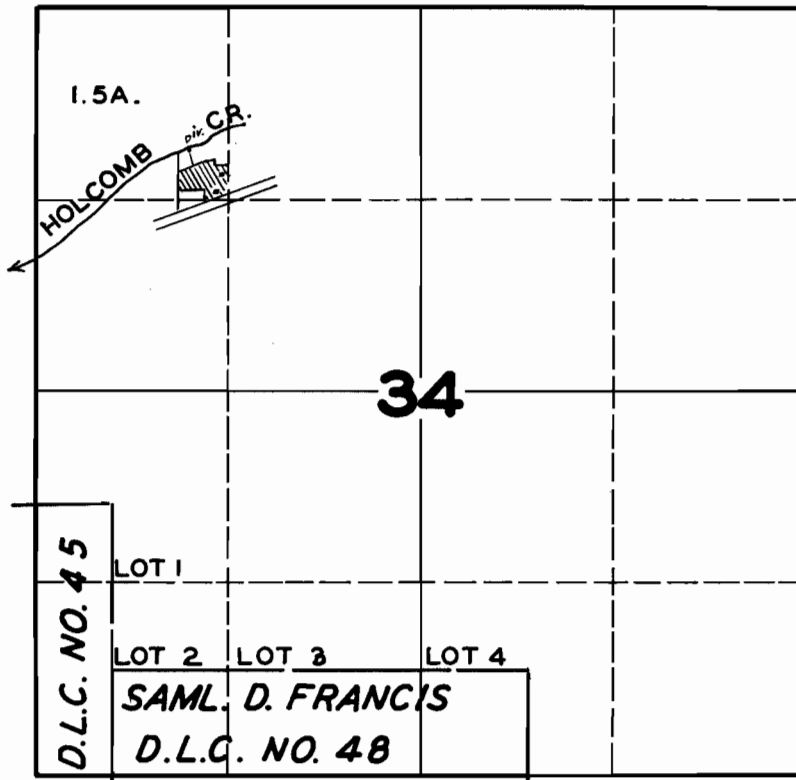

FINAL PROOF SURVEY UNDER

Application No. 18898 Permit No. 14513
IN NAME OF

JAMES E. & EILEEN GAGE

Surveyed AUG. 12, 1948, by JAS. E. BUNNELL