


**T.6S.R.1W.W.M.**

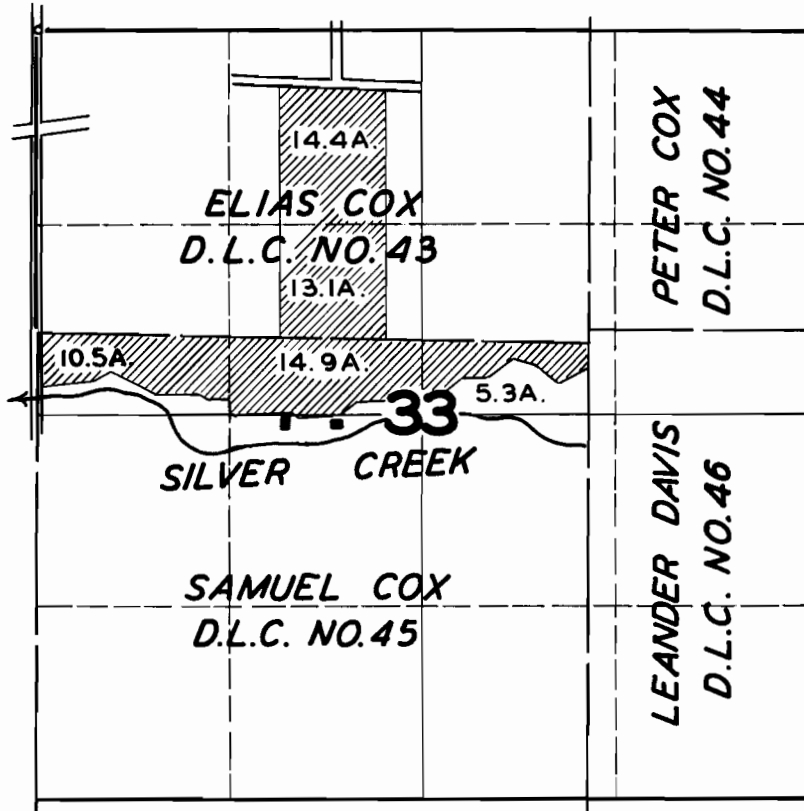

**FINAL PROOF SURVEY**  
UNDER

Application No. **18958** Permit No. **14560**  
IN NAME OF

**ALFRED G. SCHEIDLER**

Surveyed **MAR. 23, 1948**, by **JAS. E. BUNNELL**