


T.13S.R.7W.W.M.

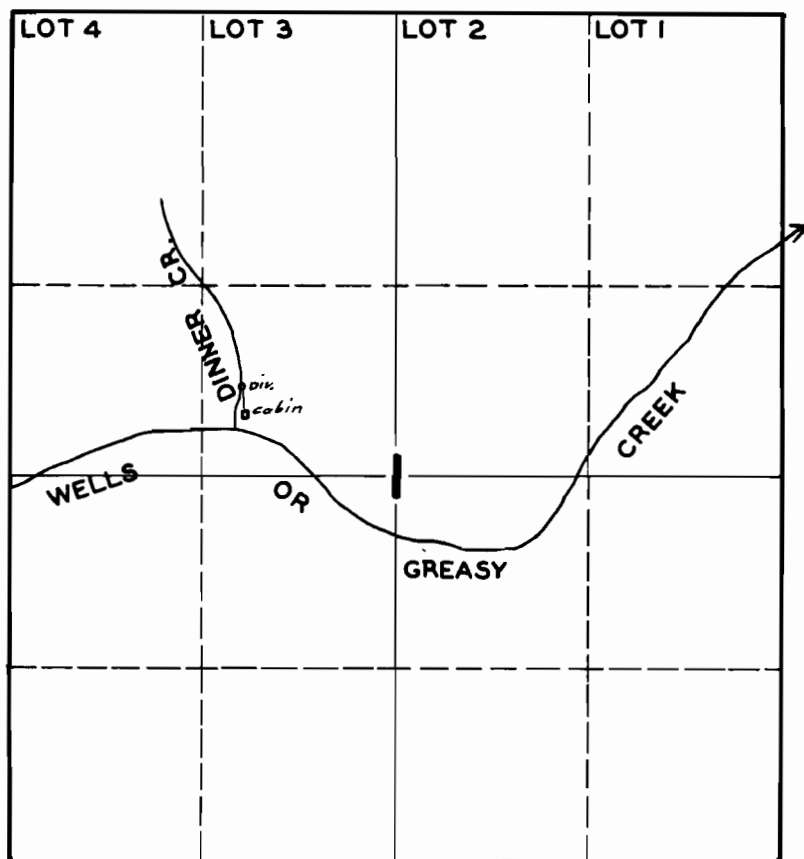

FINAL PROOF SURVEY

Application No. **18884** Permit No. **14586**
IN NAME OF

JOHN C. ROLLINS

Surveyed JULY 1 1948, by JAS. E. BUNNELL