


# T. 11S. R. 7W.W.M.

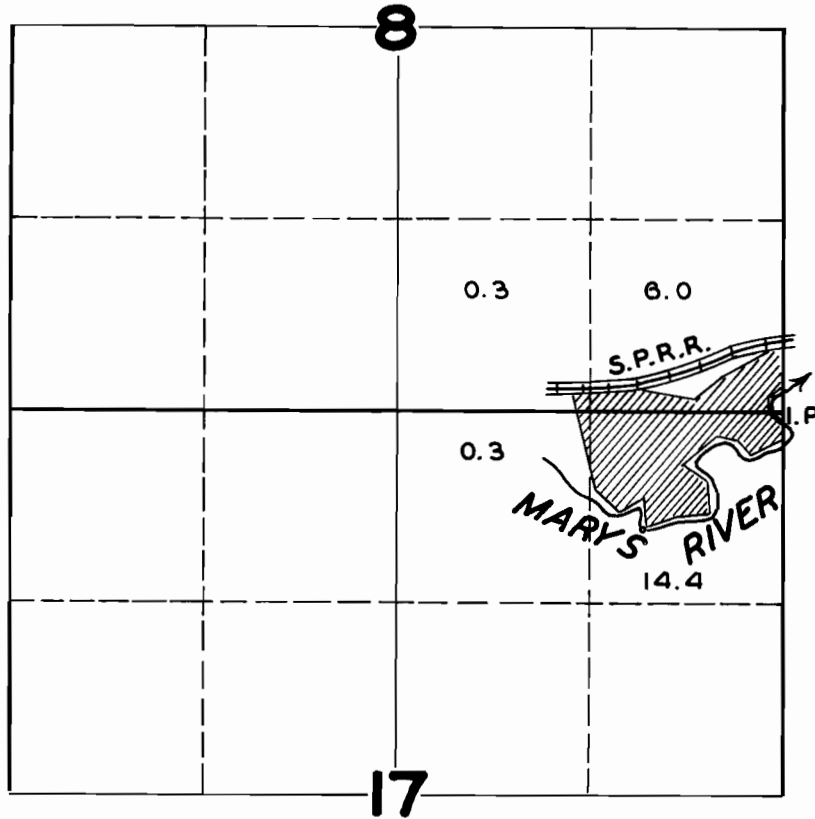

## FINAL PROOF SURVEY

UNDER

Application No. **19092** Permit No. **L4683**

IN NAME OF

**J. K. UNDERHILL**

Surveyed **APR. 8** 1949, by **JAS. E. BUNNELL**