


# T. IS. R. 3 & 4 W. W. M.

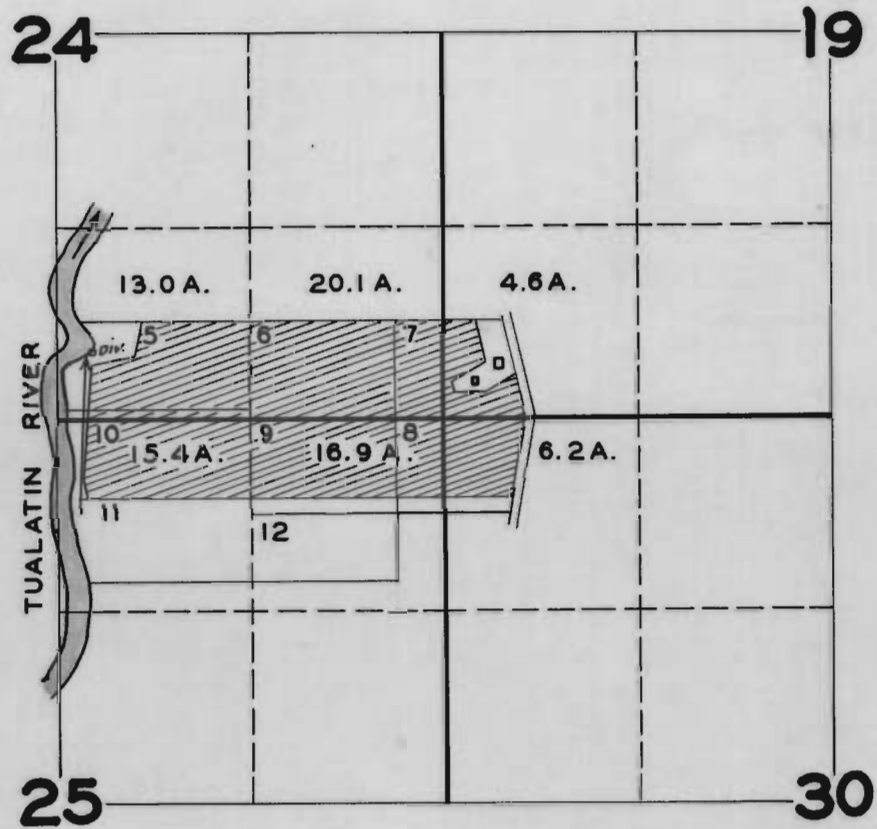

## FINAL PROOF SURVEY UNDER

Application No. 19224 Permit No. 14813  
IN NAME OF

J. T. VANDYKE

Surveyed JULY 15, 1947, by JAS. E. BUNNELL