


T.10S. R.4 & 5 W.W.M.

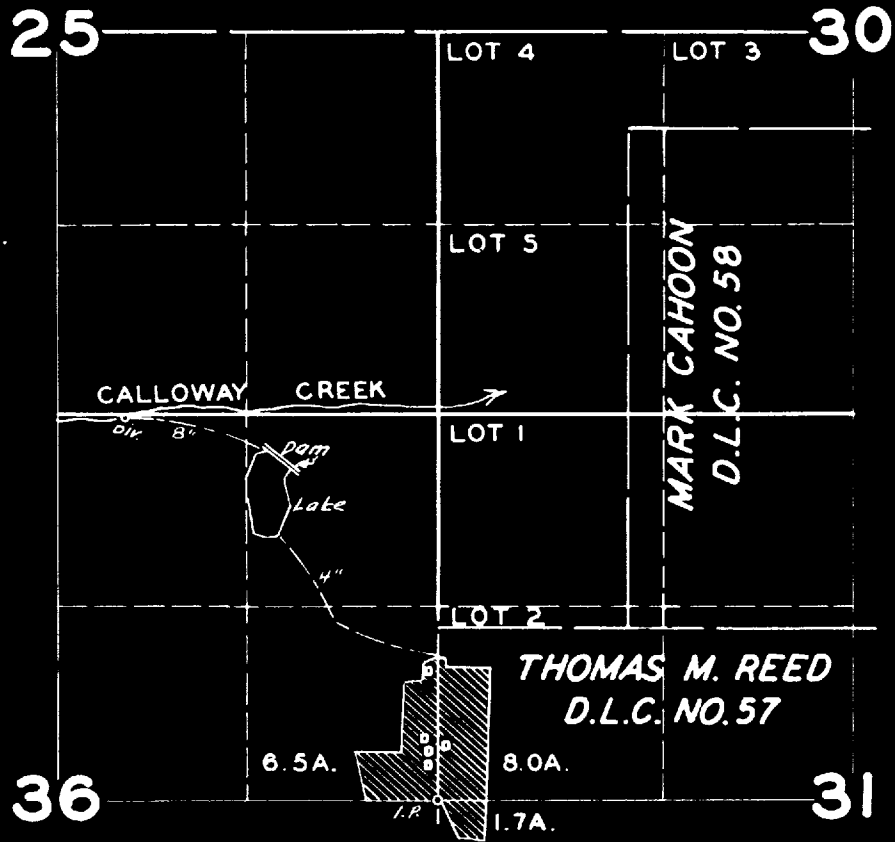

FINAL PROOF SURVEY

UNDER

16744

12526

Application No. R-16745 Permit No. R-704

IN NAME OF

STATE OF OREGON - BOARD OF FORESTRY

Surveyed JULY 15 1948, by JAS. E. BUNNELL