


T.5S.R.7W.W.M.

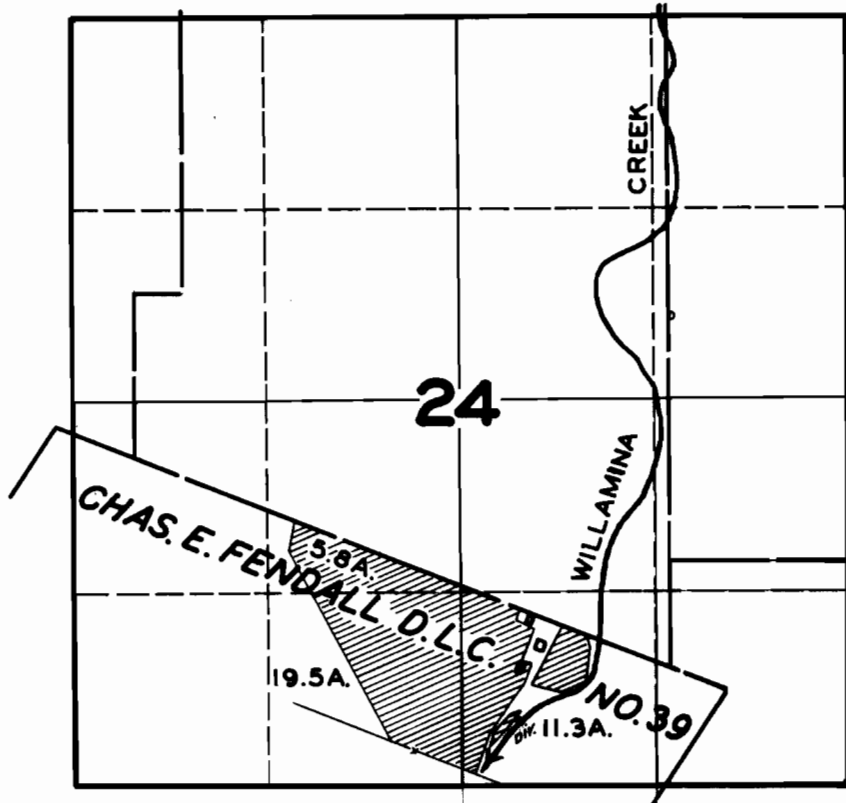

FINAL PROOF SURVEY

UNDER

Application No. **19232** Permit No. **14911**

IN NAME OF

WARD MENDENHALL

Surveyed **MAR. 24 1947**, by **JAS. E. BUNNELL**