


T.14S.R.15E.W.M.

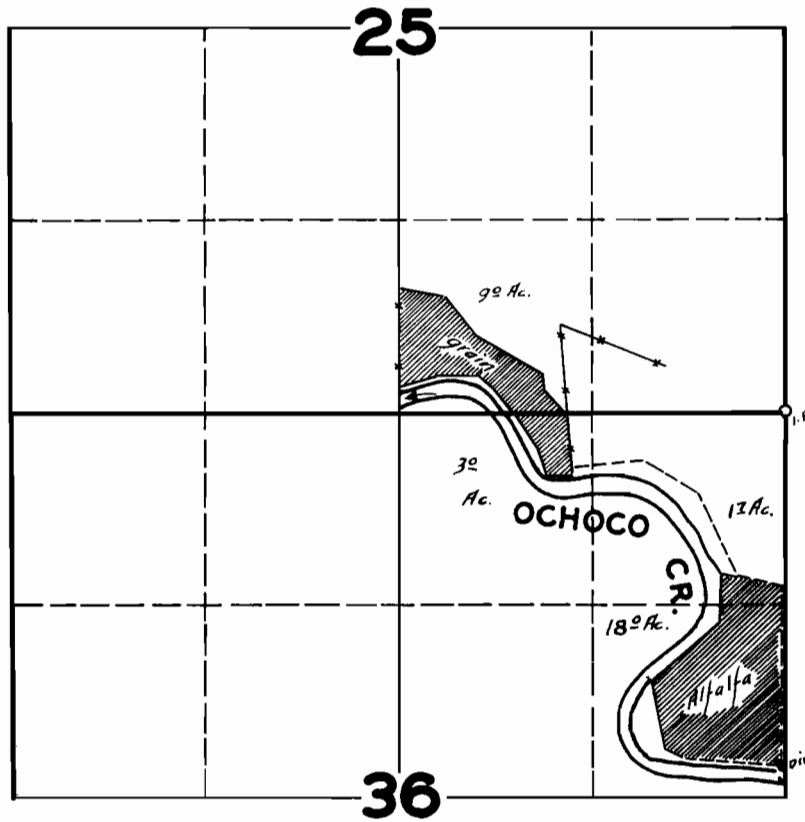

FINAL PROOF SURVEY UNDER

Application No. 19470 Permit No. 15094

IN NAME OF
ORVILLE YANCEY

Surveyed APR. 30 1946, by