


T.3S. R.8½ E.W.M.

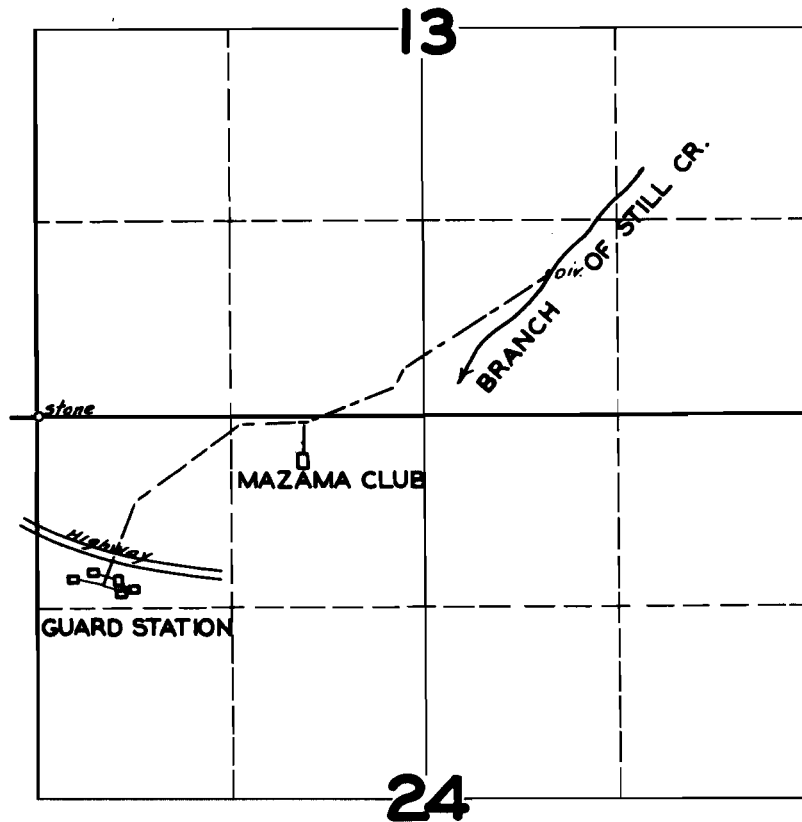

**FINAL PROOF SURVEY
UNDER**

Application No. 19604 Permit No. 15216

IN NAME OF

MT. HOOD NATIONAL FOREST - U.S. DEPARTMENT OF AGRICULTURE.

Surveyed AUG. 28 1947, by JAS. E. BUNNELL