


T.3 S. R.9 E.W.M.

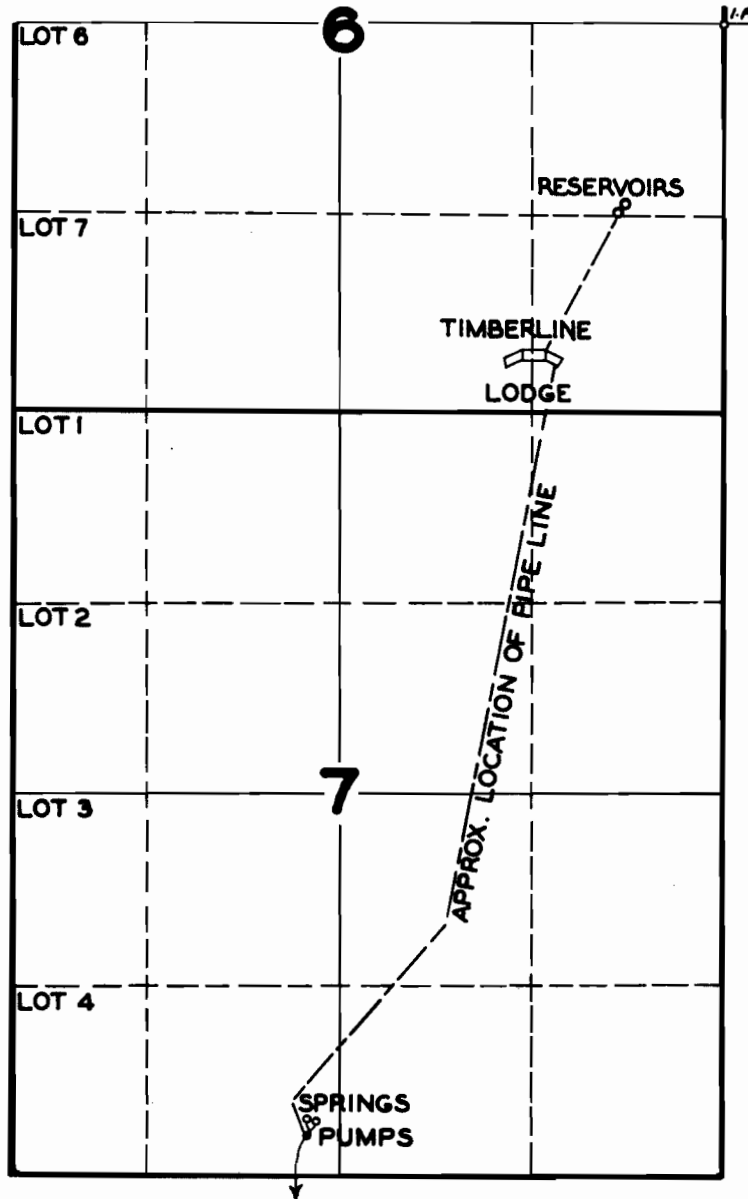

FINAL PROOF SURVEY UNDER

Application No. 19621 Permit No. 15220

IN NAME OF

MT. HOOD NATIONAL FOREST - U.S. DEPARTMENT OF AGRICULTURE

Surveyed AUG. 28 1947, by JAS. E. BUNNELL