


D 15239
16868

T.13S. R.31E. W.M.

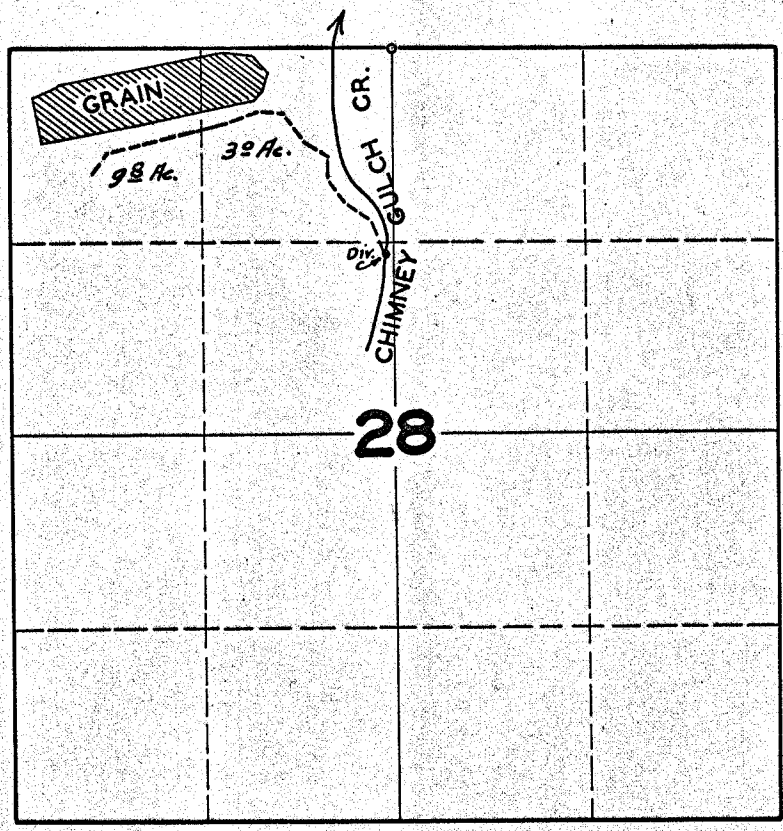

FINAL PROOF SURVEY UNDER

Application No. 19657 Permit No. 15239
IN NAME OF
LOUIS MORRIS

Surveyed MAY 20 1947, by JAS. E. BUNNELL