


T.14S. R.5W.W.M.

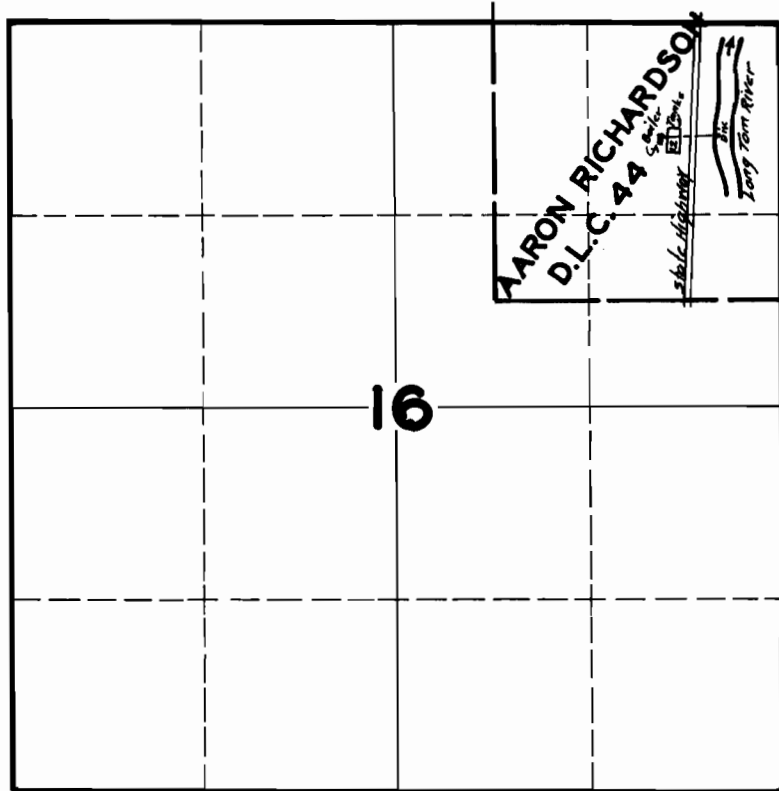

FINAL PROOF SURVEY

UNDER

Application No. 19673 Permit No. 15254

IN NAME OF

BENTON COUNTY FLAX GROWERS CO-OP

Surveyed MAY 7, 1946 by [Signature]