


T.11S. R.35½ & 36E.W.M.

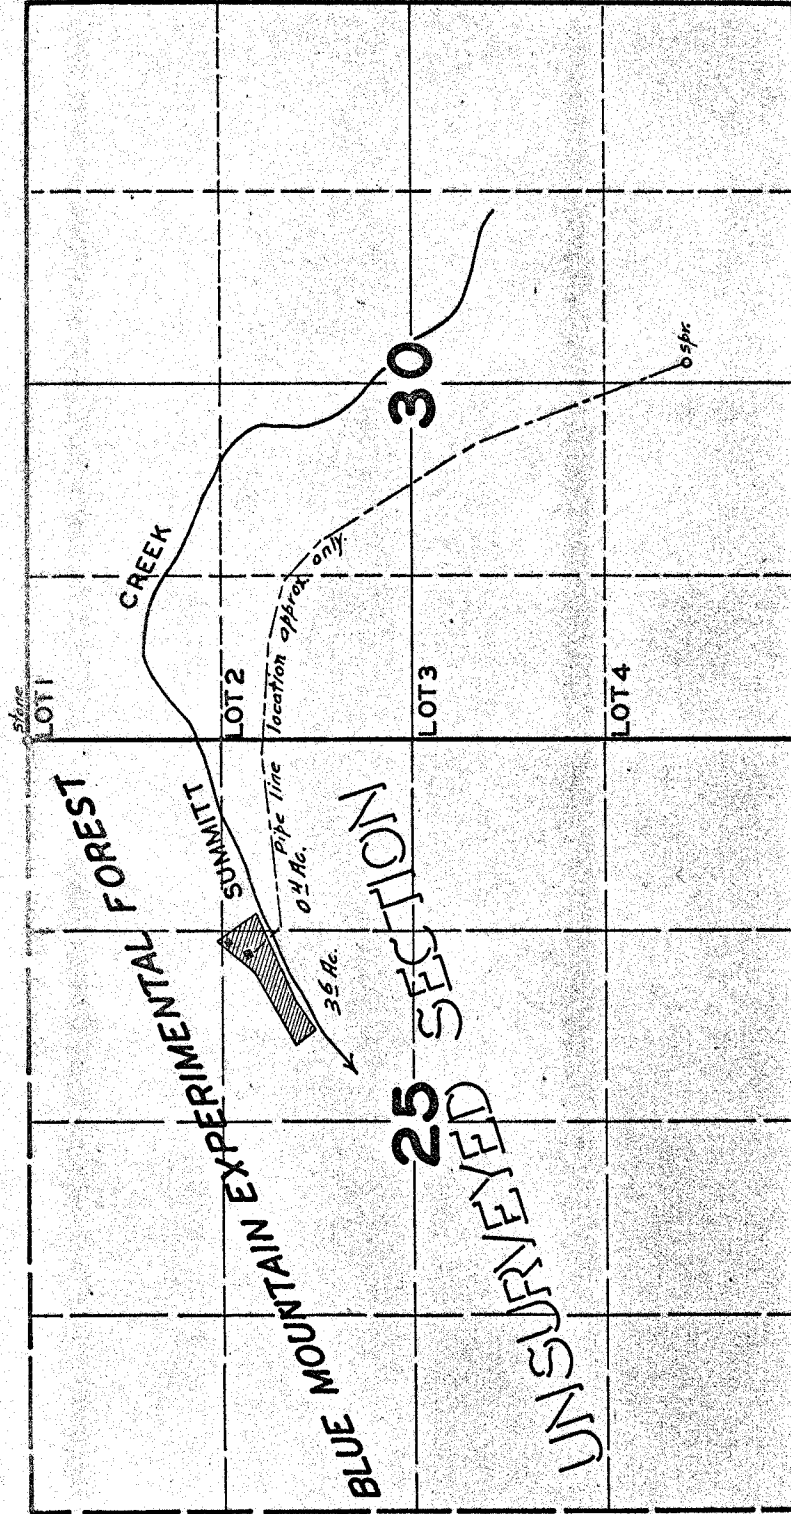

FINAL PROOF SURVEY
UNDER

Application No. 19690 Permit No. 15269

IN NAME OF

UNITED STATES DEPARTMENT OF AGRICULTURE - WHITMAN NATIONAL FOREST

Surveyed MAY 12 1947, by JAS. E. BUNNELL

Per. 15269
16870