


T. IS. R. IW. W. M.

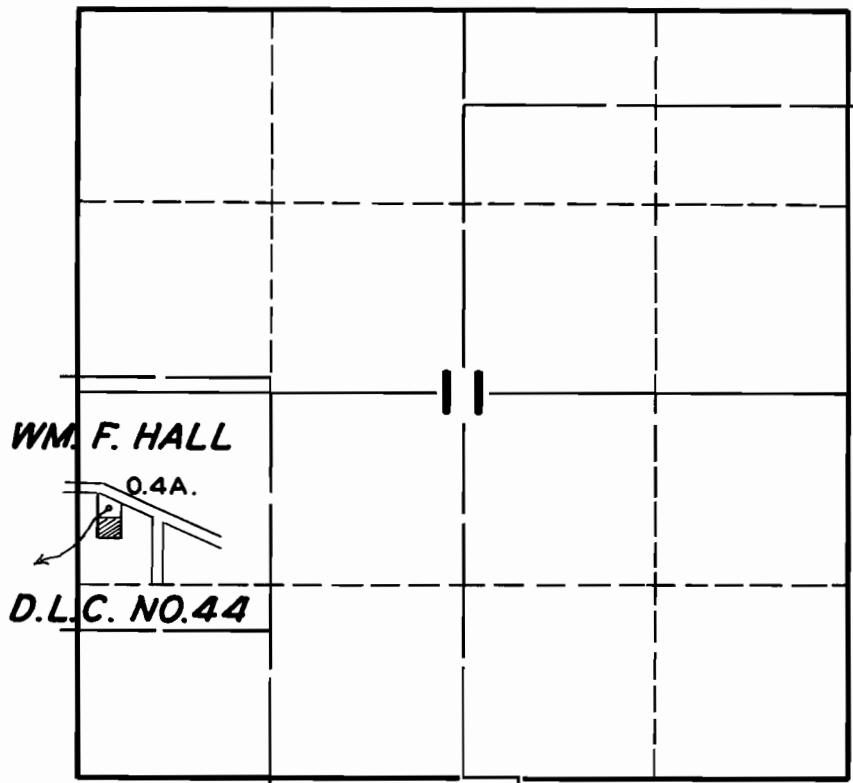

FINAL PROOF SURVEY

UNDER

Application No. **19691**..... Permit No. **15270**.....

IN NAME OF

FRED A. & RUTH M. COOK.....

Surveyed **MAY 5**... 19**48**, by **JAS. E. BUNNELL**