


T.4S.R.4E.W.M.

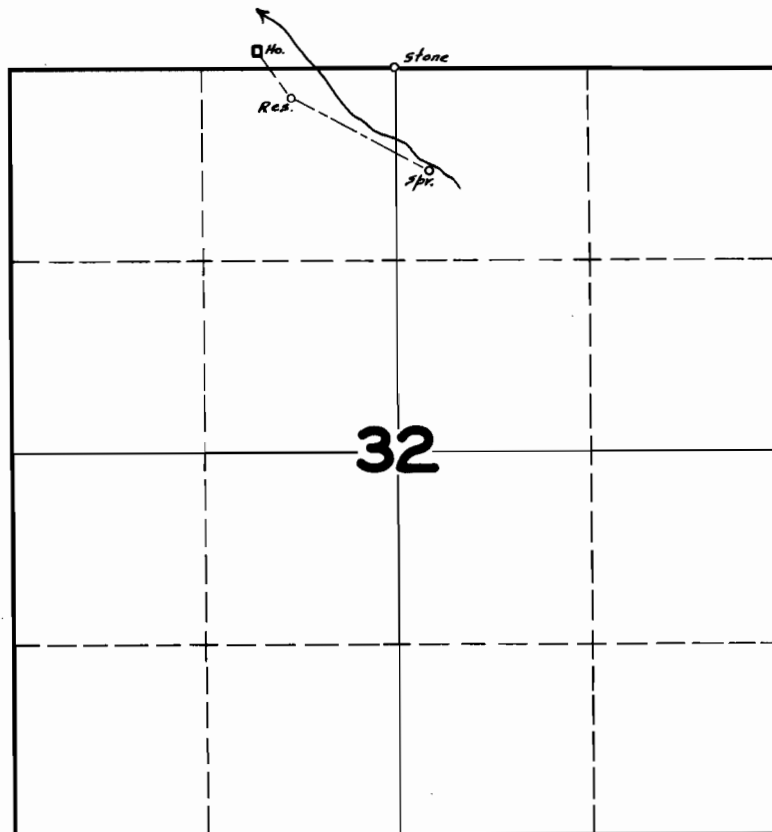

**FINAL PROOF SURVEY
UNDER**

Application No. 19747 Permit No. 15333

IN NAME OF

CHRIS BITTNER

Surveyed JUN. 18, 1947, by JAS. E. BUNNELL