


T.I.S.R.I.E.W.M.

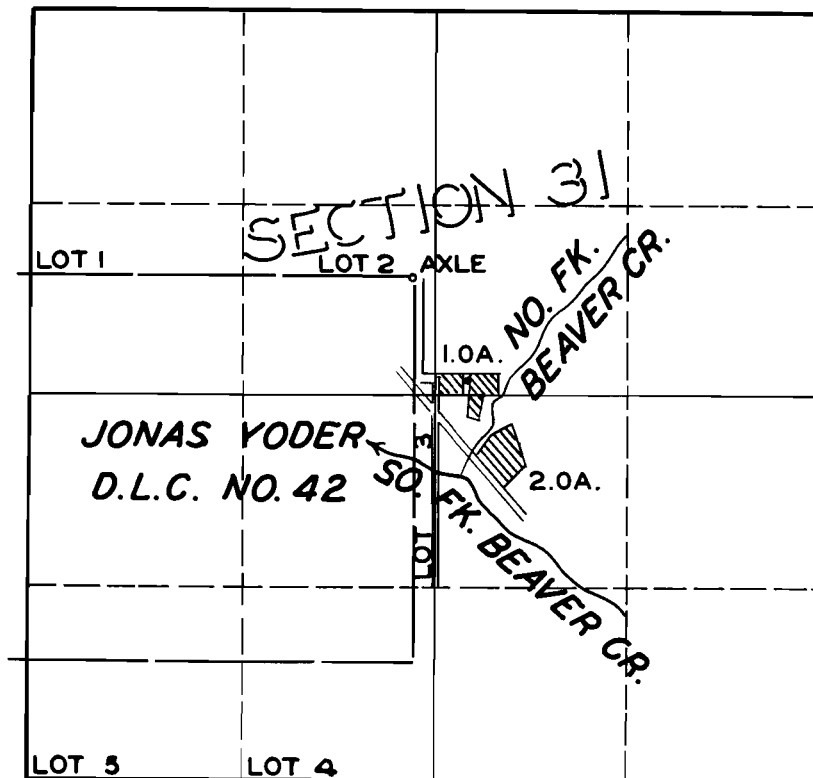

**FINAL PROOF SURVEY**  
UNDER

Application No. 19753 Permit No. 15339  
IN NAME OF

CLINTON UFFORD

Surveyed APR. 26 1948, by JAS. E. BUNNELL