


T. 5S. R. 1W. W.M.

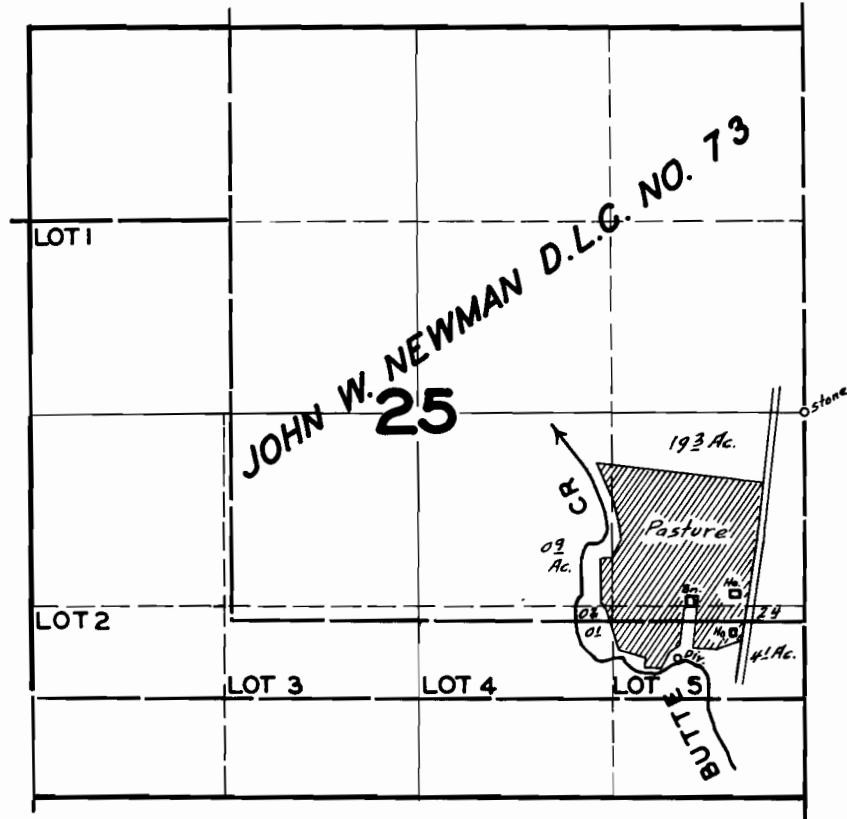

FINAL PROOF SURVEY UNDER

Application No. 19939 Permit No. 15523

IN NAME OF

W.G. WOLFE

Surveyed OCT. 1, 1947, by JAS. E. BUNNELL