


T.9S.R.1W.W.M.

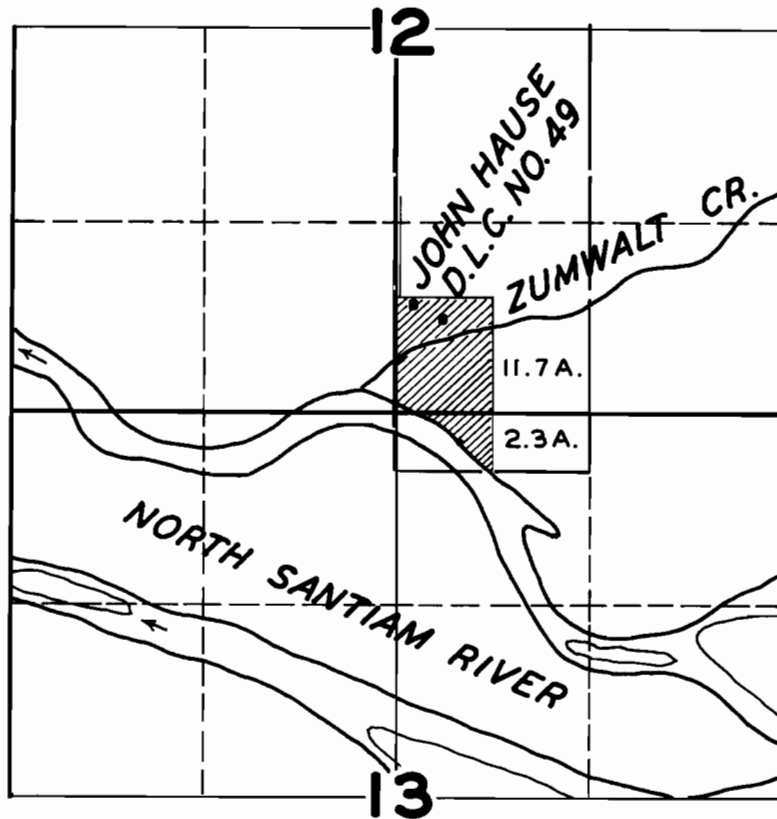

FINAL PROOF SURVEY

UNDER

Application No. **1982**... Permit No. **15547**...

IN NAME OF

HENRY F. MINTEN

Surveyed **MAR. 31, 1949**, by **JAS. E. BUNNELL**