


T.8S.R.39E.W.M.

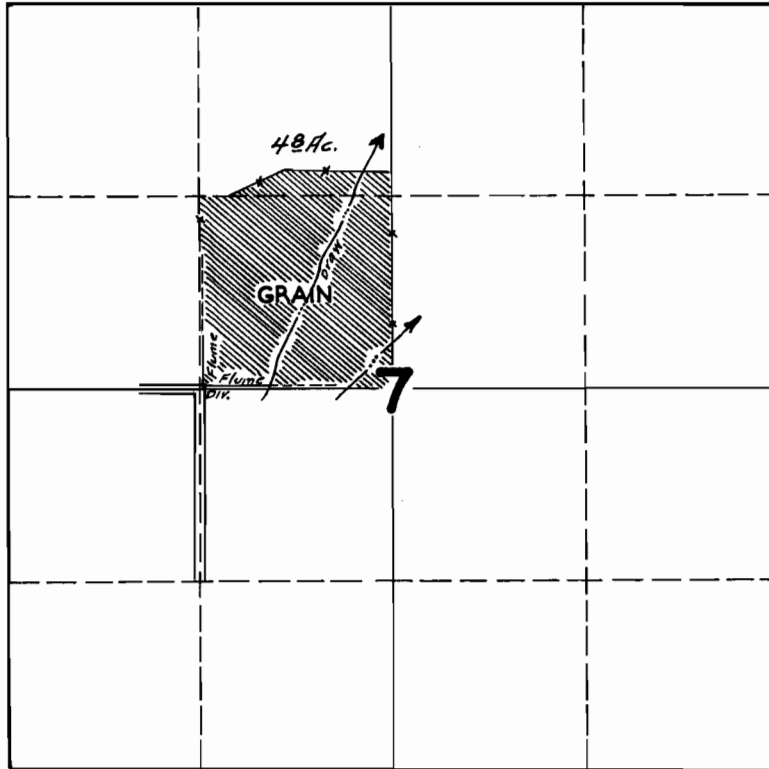

FINAL PROOF SURVEY UNDER

Application No. 1974 Permit No. 15572

IN NAME OF

FLUVIA H. NICOL

Surveyed MAY 15, 1947, by JAS. E. BUNNELL