


T.17S.R.1W.W.M.

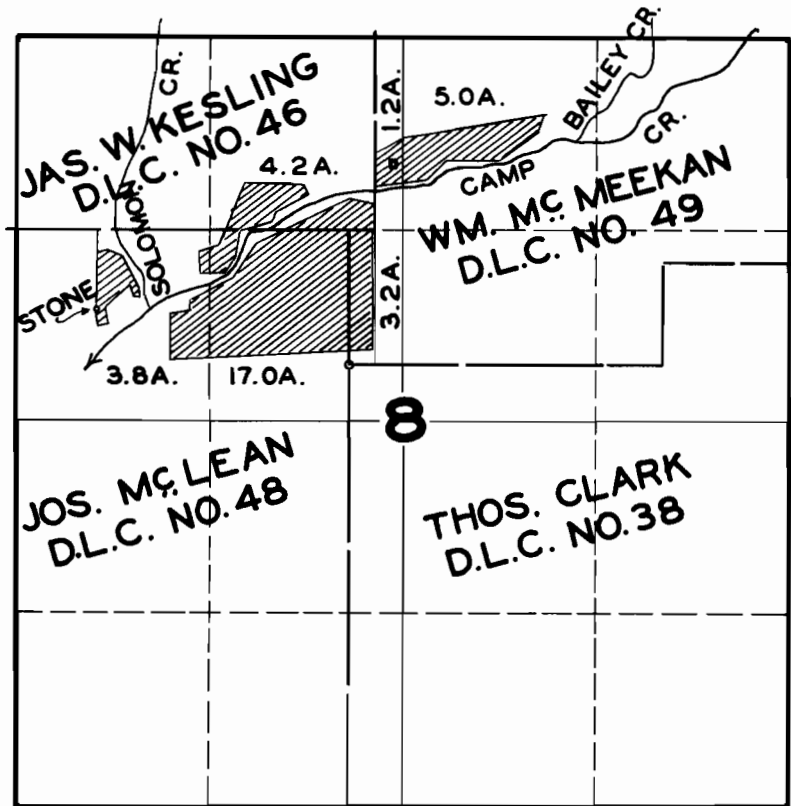

FINAL PROOF SURVEY
UNDER

Application No. 20120 Permit No. 15686
IN NAME OF

DELBERT G. SIKES

Surveyed JUNE 22 1948, by JAS. E. BUNNELL